

Pearl River
F 10
2-18-70

MISSISSIPPI
BOARD OF WATER COMMISSIONERS
416 North State Street
Jackson, Mississippi 39201

CODED

WATER WELL DRILLERS LOG

2-18 1970 E. J. Waterwell Serv. Pearl River
date well completed firm name county well located

LANDOWNER:
Johnnie Smith Jr.
Poplarville Miss.
(mailing address)

WELL LOCATION:
sec. 15 T 2 N R 16 E
3 miles west of Poplarville
(distance) (direction) (nearest town)

WELL PURPOSE: Home
(home, irrigation, municipal, industrial)

WELL COMPLETION DATA:
(1) diameter (inches) 4.5
(2) total depth (feet) 257
(3) static water level (feet) 130 below top of ground.
(4) casing (material) 2.52 (depth)
2" (size) if telescope see back.
(5) screen 5' (length) 252 (depth to top)
2 (size) 5.5 (material)
(6) pump 1/2 (HP) 400 (yield gpm)
Elect. (type power)
(7) electric log NO (yes or no)
(organization running log)
(8) how well bottom plugged Shoe

description of formations encountered	from	to
Surface C. clay	0	3
Coarse sd. & gravel	3	10
Red & white clay	10	30
White & Blue clay #1	30	177
Soft Blue clay	177	191
Hard Blue clay	191	200
Soft Blue clay	200	231
medium white sd	231	270

CODED


MAR 26 1970

MISS. BD. OF
WATER COMM.

DRILLERS REMARKS:

If well telescopes please sketch and show depths.

GROUND LEVEL

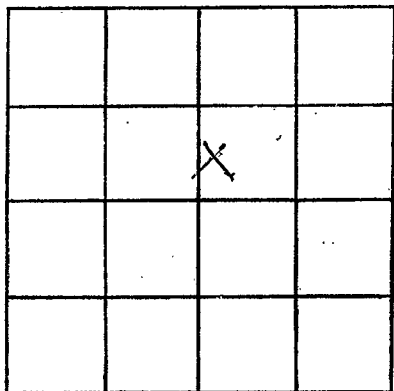

SECTION 15

Please indicate well location X.

ADDITIONAL INFORMATION

If more than one screen,
show locations of each on sketch.