

PEARL RIVER

F 12

9-15-70

MISSISSIPPI BOARD OF WATER COMMISSIONERS 416 North State Street Jackson, Mississippi 39201

CODED

WATER WELL DRILLERS LOG

NEIL LUMPKIN WELL DRILLING SERVICE

P. O. BOX 117

GARFIELD, MISS.

county well located

9-15 date well completed

1970

Pearl River

LANDOWNER: Sever-C Ranch 90 Jm Henry Wilson 3933 Stewart St.

description of formations encountered

from to

Jackson, Miss. (mailing address)

white & blue clay 0 110

WELL LOCATION:

sec 3 T 2 S R 16 W

6 miles N of Poplarville (distance) (direction) (nearest town)

Med. grey siliceous sand 110 150

WELL PURPOSE: Tractor (home, irrigation, municipal, industrial)

WELL COMPLETION DATA:

- (1) diameter (inches) 2"
(2) total depth (feet) 150
(3) static water level (feet) 40 below top of ground
(4) casing galv. 144" (material) (depth) 2" (size) if telescope see back.
(5) screen 5 (length) (depth to top) 2" (size) 5. Steel (material)
(6) pump 1/2 (HP) 400. phr. (yield gpm) electric (type power)
(7) electric log No. (yes or no)

CODED

(organization running log)

(8) how well bottom plugged


Johnson BP valve

DRILLERS REMARKS:

NOV 3 1970 MISS. Bd. OF WATER COMMISSIONERS

If well telescopes please sketch and show depths.

GROUND LEVEL

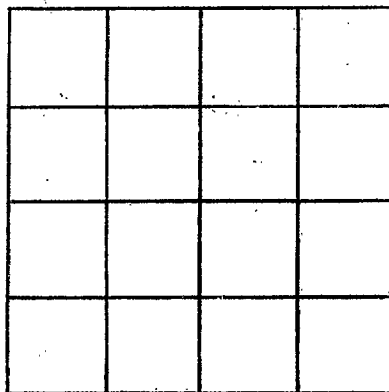

SECTION _____

Please indicate well location X.

ADDITIONAL INFORMATION

If more than one screen, show locations of each on sketch.