

F-17
6-61

WATER WELL DRILLERS LOG

F

Date: June, 1961, Driller: Leo Sadre
(Name) **CODED**

(1) Owner of Land:	Description & Color of Materials Sand, Clay, Red Clay, Shell, etc.	Thick- ness Feet	Depth Feet
<u>199-9</u> <u>Amerson Stewart</u> (Name)	<u>Red clay</u>	<u>280-28</u>	<u>28</u>
<u>St Poplarville</u> (Address)	<u>Sand</u>	<u>23</u>	<u>21-27</u>
(2) Location: <u>1/4</u> , <u>1/4</u> , Sec. <u>14 T.2R16</u>	<u>White clay</u>	<u>107</u>	<u>51-158</u>
<u>3</u> miles <u>West</u> of <u>Poplarville</u> (distance) (direction) (Nearest Town)	<u>Moistland</u>	<u>15</u>	<u>138-173</u>
(3) Topography: <input checked="" type="checkbox"/> (Hilly) <input type="checkbox"/> (Flat) <input type="checkbox"/> (Level)			
(4) Purpose of Well: <u>Home Use</u> (Domestic Irrigation Municipal, Industrial, Other)			


Information upon completion of well:

- (1) Diameter 2 inches.
- (2) Total Depth 173 feet.
- (3) Water Level 70 feet below top of ground.
- (4) Cased to 162, Size 2"
- (5) Screen: Size 100, Length 10ft
- (6) Were any formations sealed against pollution?
yes, no.

If YES depth of formation _____
Why _____

Drillers Remarks: _____

CODED

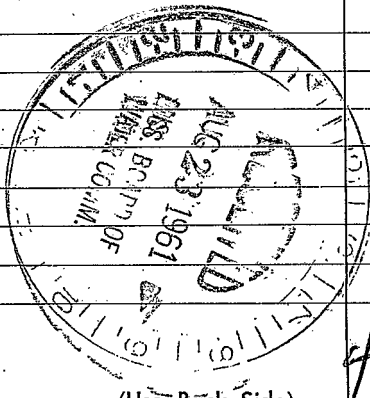

(Use Back Side)

Well No. 45

[The page contains extremely faint and illegible text, likely bleed-through from the reverse side of the document. No specific words or phrases can be discerned.]