

F-20
3-2-62
32

WATER WELL DRILLERS LOG

Date: br, 1962, Driller: Les L. L. Parker County: Pearl River

CODED

(1) Owner of Land: Leahy, John

(Name)

(Address)

Description & Color of Materials
Sand, Clay, Red Clay, Shell, etc.

Thick-
ness
Feet

Depth
Feet

(2) Location: 1/4, 1/4, Sec. 23 T2R16

2 miles west, of PP
(distance) (direction) (Nearest Town)

(3) Topography: Flat
(Hilly) (Flat) (Level)

(4) Purpose of Well: Domestic Use

(Domestic Irrigation
Municipal, Industrial, Other)

Information upon completion of well:

(1) Diameter 4 inches.

(2) Total Depth 87 feet.

(3) Water Level 56 feet below top of ground.

(4) Cased to 87, Size 4"

(5) Screen: Size 040, Length 6'

(6) Were any formations sealed against pollution?


yes, no.

If YES depth of formation _____

Why _____

Drillers Remarks: _____

CODED

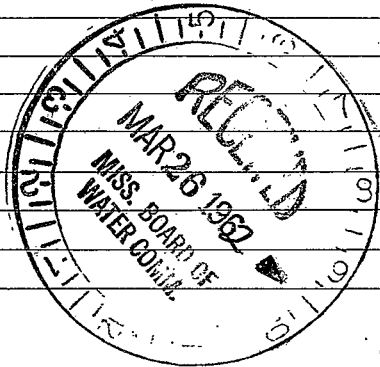

(Use Back Side)

63

Well No.

