

Pearl River
F 26
10-14-71

MISSISSIPPI
 BOARD OF WATER COMMISSIONERS
 416 North State Street
 Jackson, Mississippi 39201

CODED

WATER WELL DRILLERS LOG

10-14 1971 **Earl Perstad water well serv. Pearl River**
 date well completed firm name county well located

LANDOWNER:
Dr. W.M. Pounds
Poplarville miss.
 (mailing address)

description of formations encountered	from	to
yellow sd.	0	4
Red clay	4	20
white clay	20	50
Blue clay	50	176
fine blue sd.	176	192
Blue clay	192	193
gray coarse sd.	193	220

WELL LOCATION:
 sec. 16 T. 2 N. R. 16 E. S. 1 W. 1
5 miles N.W. of Poplarville
 (distance) (direction) (nearest town)

WELL PURPOSE: Home
 (home, irrigation, municipal, industrial)

- WELL COMPLETION DATA:**
- (1) diameter (inches) 7 1/2
 - (2) total depth (feet) 220
 - (3) static water level (feet) 105 below top of ground.
 - (4) casing Plastic, 2 1/2
 (material) (depth)
4"
 (size) If telescope see back.
 - (5) screen 10', 2 1/2
 (length) (depth to top)
4" Plastic
 (size) (material)
 - (6) pump 1 1/2 Sub. 1700 P.H.
 (HP) (yield gpm)
Elect
 (type power)
 - (7) electric log NO
 (yes or no)
 (organization running log)
 - (8) how well bottom plugged Slack

CODED


NOV 29 1971

MISS. DE. OF
 WATER COM.

DRILLERS REMARKS:

If well telescopes please sketch and show depths.

GROUND LEVEL

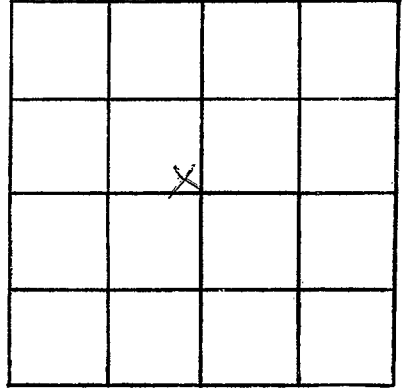

SECTION 16

Please indicate well location X.

ADDITIONAL INFORMATION

If more than one screen,
show locations of each on sketch.