

PEARL RIVER
F 27
1-10-72

MISSISSIPPI
 BOARD OF WATER COMMISSIONERS
 416 North State Street
 Jackson, Mississippi 39201

WATER WELL DRILLERS LOG **CODED**

JAN 10 19 72 Horace A Poole Pearl River
 date well completed firm name county well located

LANDOWNER: Robert Pittman
RT # 3 Poplarville
Miss
 (mailing address)

description of formations encountered	from	to
<u>Surface Clay</u>	<u>0</u>	<u>15</u>
<u>SAND</u>	<u>15</u>	<u>25</u>
<u>CLAY</u>	<u>25</u>	<u>40</u>
<u>SAND</u>	<u>40</u>	<u>65</u>

WELL LOCATION:
 sec. 28 2 N 16 E
 S W
4 miles SW of Poplarville
 (distance) (direction) (nearest town)

WELL PURPOSE: HOME
 (home, irrigation, municipal, industrial)

- WELL COMPLETION DATA:
- (1) diameter (inches) 4 1/2
 - (2) total depth (feet) 65
 - (3) static water level (feet) 30 below above top of ground.
 - (4) casing PVC 60
 (material) (depth)
2"
 (size) if telescope see back.
 - (5) screen 5 60
 (length) (depth to top)
009 PVC
 (size) (material)
 - (6) pump 1 10
 (HP) (yield gpm)
Clee
 (type power)
 - (7) electric log no
 (yes or no)
- (organization running log)
- (8) how well bottom plugged BACK
WAS A VALUE

CODED


JAN 12 1972

DRILLERS REMARKS:

MISS. Bd. of
 WATER COMMISSIONERS

If well telescopes please sketch and show depths.

GROUND LEVEL

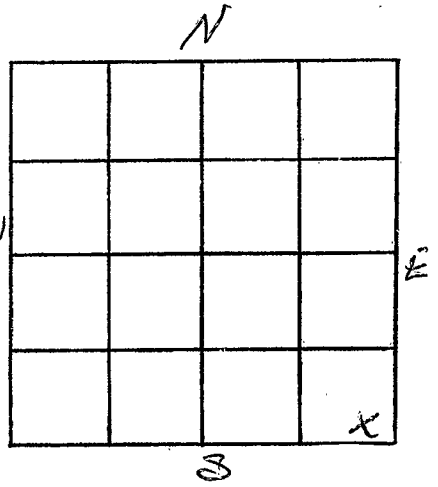

SECTION 203

Please indicate well location X.

ADDITIONAL INFORMATION

If more than one screen,
show locations of each on sketch.