

Pearl River
F28
12-12-71

MISSISSIPPI
 BOARD OF WATER COMMISSIONERS
 416 North State Street
 Jackson, Mississippi 39201

CODED

WATER WELL DRILLERS LOG

12-12- 1971 Horace A Poole Pearl River
 date well completed firm name county well located

LANDOWNER: Overt's Smith
Poplarville Miss
 (mailing address)

description of formations encountered	from	to
<u>Surface Clay</u>	<u>0</u>	<u>15</u>
<u>Clay</u>	<u>15</u>	<u>70</u>
<u>Silt</u>	<u>70</u>	<u>90</u>
<u>Clay</u>	<u>90</u>	<u>210</u>
<u>Sand</u>	<u>210</u>	<u>230</u>

WELL LOCATION:
 sec 28 T 2 S R 16 E
5 miles SW of Poplarville
 (distance) (direction) (nearest town)

WELL PURPOSE: Home
 (home, irrigation, municipal, industrial)

- WELL COMPLETION DATA:
- (1) diameter (inches) 4 1/2
 - (2) total depth (feet) 230
 - (3) static water level (feet) 60 below above of ground.
 - (4) casing Pvc, 210
 (material) (depth)
2" if telescope see back.
 (size)
 - (5) screen 10', 200
 (length) (depth to top)
010, Pvc
 (size) (material)
 - (6) pump 1, 6
 (HP) (yield gpm)
Clc
 (type power)
 - (7) electric log NO
 (yes or no)

CODED

(organization running log)

JAN 12 1972


(8) how well bottom plugged Back
WAS A VALVE

MISS. BD. OF
 WATER COMM

DRILLERS REMARKS:

If well telescopes please sketch and show depths.

GROUND LEVEL

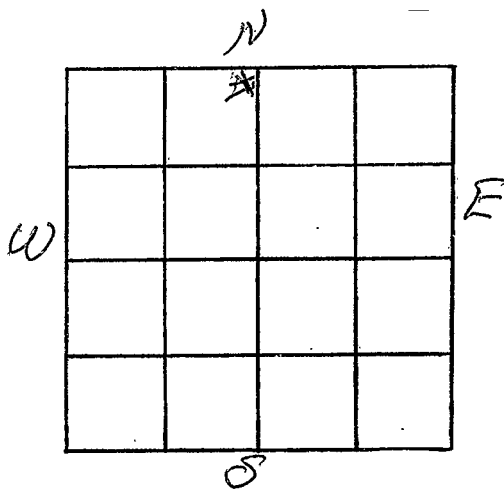

SECTION 28

Please indicate well location X.

ADDITIONAL INFORMATION

If more than one screen,
show locations of each on sketch.