

**Pearl River**  
**LF 29**  
**1-24-72**

MISSISSIPPI  
 BOARD OF WATER COMMISSIONERS  
 416 North State Street  
 Jackson, Mississippi 39201

**CODED**

WATER WELL DRILLERS LOG

1-24 1972 Bud Peterson Pearl River  
 date well completed firm name county well located

LANDOWNER: Theodore  
 Poplarville, Miss.

description of formations encountered	from	to
	White Shale	0
Sand & Gravel	12	36

(mailing address)

WELL LOCATION:

sec 32 T 2 N R 16 W  
 4 miles W of Poplarville  
 (distance) (direction) (nearest town)

WELL PURPOSE: Home  
 (home, irrigation, municipal, industrial)

WELL COMPLETION DATA:

- diameter (inches) 2 in
- total depth (feet) 36
- static water level (feet) 14 below top of ground.
- casing PVC 31 (material) (depth)  
 (size) If telescope see back.
- screen 2x5 31 (length) (depth to top)  
 2x5 PVC no 12 (size) (material)
- pump 1/2 450 (HP) (yield gpm)  
 electric (type power)
- electric log No (yes or no)

(organization running log)

(8) how well bottom plugged Sand Shark

DRILLERS REMARKS:


**CODED**

JAN 31 1972

MISS. BD. OF  
 WATER COMMISSIONERS

If well telescopes please sketch and show depths.

GROUND LEVEL

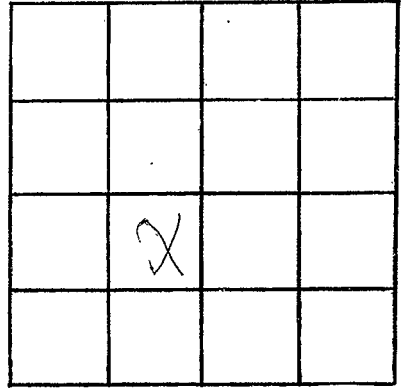

SECTION \_\_\_\_\_

Please indicate well location X.

ADDITIONAL INFORMATION

If more than one screen, show locations of each on sketch.