

**PEARL RIVER**  
**F30**  
**2-14-72**

MISSISSIPPI  
 BOARD OF WATER COMMISSIONERS **MAR 8 1972**  
 416 North State Street  
 Jackson, Mississippi 39201

**CODED**

**WATER WELL DRILLERS LOG**

2-14 1972 Bud Kenton & Son Pearl River  
 date well completed firm name county well located

LANDOWNER: Jake Woodward  
Osplanville, Miss.  
 (mailing address)

description of formations encountered	from	to
<u>Red Shale</u>	<u>0</u>	<u>6</u>
<u>Blue Shale</u>	<u>6</u>	<u>65</u>
<u>White Sand &amp; Rock</u>	<u>65</u>	<u>70</u>

**WELL LOCATION:**

sec. 10 T. 2 N. R. 16 E  
 S  
2 miles W of Osplanville  
 (distance) (direction) (nearest town)

WELL PURPOSE: Home  
 (home, irrigation, municipal, industrial)

**WELL COMPLETION DATA:**

- (1) diameter (inches) 2 in
- (2) total depth (feet) 90
- (3) static water level (feet) 18 ft below top of ground.
- (4) casing PVC 85 ft  
 (material) (depth)
- (size) if telescope see back.
- (5) screen 5 ft 85 ft  
 (length) (depth to top)
- 2x5 PVC NO12  
 (size) (material)
- (6) pump 1/2 450  
 (HP) (yield gpm)
- electric  
 (type power)
- (7) electric log NO  
 (yes or no)

**CODED**


(organization running log)

(8) how well bottom plugged Sand Shale

DRILLERS REMARKS:

If well telescopes please sketch and show depths.

GROUND LEVEL

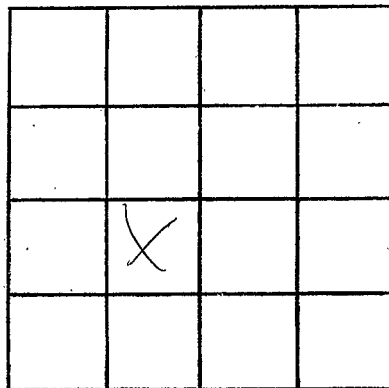

SECTION \_\_\_\_\_

Please indicate well location X.

ADDITIONAL INFORMATION

If more than one screen, show locations of each on sketch.