

PEARL RIVER
F 31
12-13-71

MISSISSIPPI
 BOARD OF WATER COMMISSIONERS
 416 North State Street
 Jackson, Mississippi 39201

WATER WELL DRILLERS LOG

12-13 1971 21 Pearl River Water Well Serv. Pearl River Miss.
 date well completed firm name county well located

LANDOWNER:
Dr. Wm. Pounds
Poplarville Miss.
 (mailing address)

WELL LOCATION:
 sec. 16 T. 2 N. R. 16 E.
6 miles west of Poplarville
 (distance) (direction) (nearest town)

WELL PURPOSE: Home
 (home, irrigation, municipal, industrial)

- WELL COMPLETION DATA:
- (1) diameter (inches) 7 1/2
 - (2) total depth (feet) 210
 - (3) static water level (feet) 102 below top of ground
 - (4) casing Plastic 200
 (material) (depth)
4" if telescope see back.
 (size)
 - (5) screen 10' 200
 (length) (depth to top)
4" Plastic
 (size) (material)
 - (6) pump L 75th.
 (HP) (yield gpm)
Elect 129 gpm
 (type power)
 - (7) electric log NO
 (yes or no)
 - (8) how well bottom plugged Shoe


description of formations encountered	from	to
	<u>Red clay</u>	<u>0</u>
<u>white clay</u>	<u>20</u>	<u>50</u>
<u>Blue clay</u>	<u>50</u>	<u>165</u>
<u>FINE Blue sd.</u>	<u>165</u>	<u>175</u>
<u>Blue clay</u>	<u>175</u>	<u>180</u>
<u>Med Blue sd.</u>	<u>180</u>	<u>200</u>
<u>Coars. Blue sd.</u>	<u>200</u>	<u>210</u>

NOV 29 1971

DRILLERS REMARKS:

If well telescopes please sketch and show depths.

GROUND LEVEL

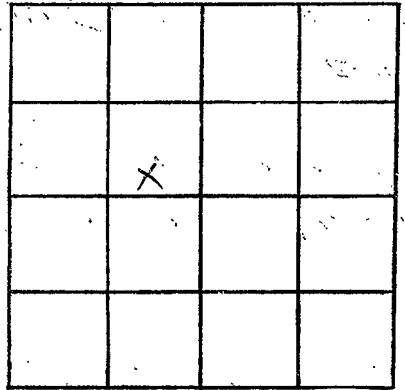

SECTION 16

Please indicate well location X.

ADDITIONAL INFORMATION

If more than one screen,
show locations of each on sketch.