

PEARL RIVER
F33
3-12-77

MISSISSIPPI
 BOARD OF WATER COMMISSIONERS
 416 North State Street
 Jackson, Mississippi 39201

CODED

WATER WELL DRILLERS LOG

03-12 1977 Bud Penton & Son Pearl River
 date well completed firm name county well located

LANDOWNER:
Albert C. Fairley
Poplarville, Miss
 (mailing address)

description of formations encountered	from	to
<u>White Shale</u>	<u>0</u>	<u>130</u>
<u>Blue shale</u>	<u>130</u>	<u>304</u>
<u>Sand</u>	<u>304</u>	<u>357</u>

WELL LOCATION:
 sec 28 T 2 N R 16 E
3 miles W of Poplarville
 (distance) (direction) (nearest town)

WELL PURPOSE: Home
 (home, irrigation, municipal, industrial)

- WELL COMPLETION DATA:
- (1) diameter (inches) 2 in
 - (2) total depth (feet) 357
 - (3) static water level (feet) 93 below above top of ground.
 - (4) casing Galv. 252
 (material) (depth)
 (size) if telescope see back.
 - (5) screen 5 ft. 252
 (length) (depth to top)
2x5 S. Steel no. 12
 (size) (material)
 - (6) pump 1 360
 (HP) (yield gpm)
electric
 (type power)
 - (7) electric log NO
 (yes or no)

CODED

(organization running log)

MAY 3 - 1977


(8) how well bottom plugged
Sand Shale

MISS. RD. OF
 WATER COMMISSIONERS

DRILLERS REMARKS:

If well telescopes please sketch and show depths.

GROUND LEVEL

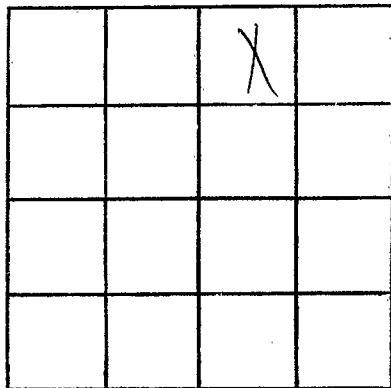

SECTION _____

Please indicate well location X.

ADDITIONAL INFORMATION

If more than one screen, show locations of each on sketch.