

PEARL RIVER
F 36
8-10-72

MISSISSIPPI
 BOARD OF WATER COMMISSIONERS
 416 North State Street
 Jackson, Mississippi 39201

WATER WELL DRILLERS LOG

CODED

8-10 1972 Earl Penton under well No. Pearl River
 date well completed firm name county well located

LANDOWNER:	description of formations encountered	from	to
<u>Kermit Smith</u> <u>Rt. 1 Poplarville Miss.</u> (mailing address)			
	<u>White Clay</u>	<u>20</u>	<u>75</u>
	<u>Blue Clay</u>	<u>75</u>	<u>216</u>
	<u>Coarse Blue sd.</u>	<u>216</u>	<u>256</u>
WELL LOCATION: sec. <u>8</u> T <u>2</u> N R. <u>16</u> E <u>8</u> miles <u>west</u> of <u>Poplarville</u> (distance) (direction) (nearest town)			
WELL PURPOSE: <u>Home</u> (home, irrigation, municipal, industrial)			
WELL COMPLETION DATA:			
(1) diameter (inches) <u>4 1/2</u>			
(2) total depth (feet) <u>256</u>			
(3) static water level (feet) <u>114</u> below/above top of ground.			
(4) casing <u>Plastic 2 1/2</u> (material) (depth)			
<u>2"</u> if telescope see back. (size)			
(5) screen <u>5'</u> <u>2 1/2</u> (length) (depth to top)			
<u>2"</u> <u>Plastic</u> (size) (material)			
(6) pump <u>1</u> <u>320</u> (HP) (yield gpm)			
<u>Elect.</u> (type power)			
(7) electric log <u>NO</u> (yes or no)			
(organization running log)			
(8) how well bottom plugged <u>Spec</u>			

CODED


NOV 27 1972

DRILLERS REMARKS:

WATER BOARD

If well telescopes please sketch and show depths.

GROUND LEVEL

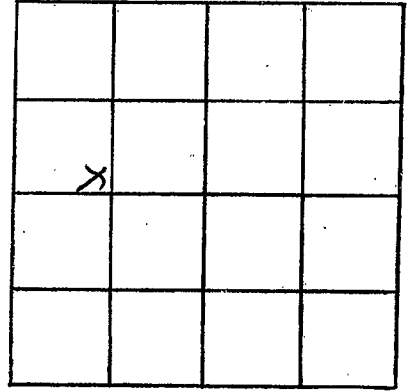

SECTION 8

Please indicate well location X.

ADDITIONAL INFORMATION

If more than one screen,
show locations of each on sketch.