

Pearl River
F 38
10-18-72

MISSISSIPPI
 BOARD OF WATER COMMISSIONERS
 416 North State Street
 Jackson, Mississippi 39201

CODED

WATER WELL DRILLERS LOG

10-18 1972 Earl Penton water well serv. Pearl River
 date well completed firm name county well located


LANDOWNER:	description of formations encountered	from	to
<u>James Howard.</u> <u>Poplarville Miss.</u> (mailing address)			
WELL LOCATION:	<u>Coarse white sd.</u>	<u>10</u>	<u>20</u>
<u>7 sec T 2 N R 16 E</u> <u>6</u> miles <u>N. East</u> of <u>Poplarville</u> (distance) (direction) (nearest town)	<u>Blue clay</u>	<u>20</u>	<u>74</u>
WELL PURPOSE: <u>Home</u> (home, irrigation, municipal, industrial)	<u>Coarse Blue sd.</u>	<u>74</u>	<u>96</u>
WELL COMPLETION DATA:			
(1) diameter (inches) <u>4 5/8</u>			
(2) total depth (feet) <u>96'</u>			
(3) static water level (feet) <u>30'</u> below above top of ground.			
(4) casing <u>Pvc</u> , <u>91'</u> (material) (depth)			
<u>2"</u> if telescope see back. (size)			
(5) screen <u>5'</u> , <u>91'</u> (length) (depth to top)			
<u>2"</u> , <u>P.V.C.</u> (size) (material)			
(6) pump <u>1/2</u> , <u>400 G.P.M.</u> (HP) (yield gpm)			
<u>Elect</u> (type power)			
(7) electric log <u>NO</u> (yes or no)			
(organization running log)			
(8) how well bottom plugged <u>Shoe</u>			
DRILLERS REMARKS:			

CODED

MISSISSIPPI
 BOARD OF WATER COMMISSIONERS
 JACKSON, MISSISSIPPI

If well telescopes please sketch and show depths.

GROUND LEVEL

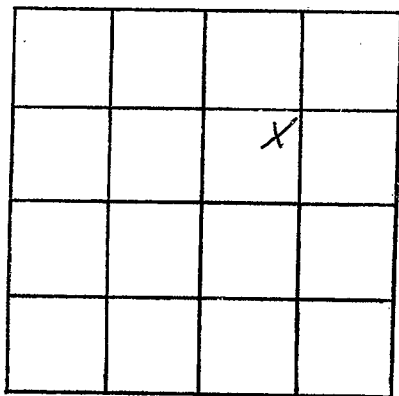

SECTION 2

Please indicate well location X.

ADDITIONAL INFORMATION

If more than one screen,
show locations of each on sketch.