

PEARL RIVER  
 F 39  
 6-23-73

MISSISSIPPI  
 BOARD OF WATER COMMISSIONERS  
 416 North State Street  
 Jackson, Mississippi 39201

**CODED**

WATER WELL DRILLERS LOG

6-23 1973 Horace A. Peole Pearl River  
 date well completed firm name county well located

LANDOWNER: Charles, Moore  
 RT # 1  
 Poplarville Miss  
 (mailing address)

description of formations encountered	from	to
SURFACE CLAY	0	12
CLAY	12	32
SAND	32	48

WELL LOCATION:  
 sec. 2 T 2 N R. 16  
 S W  
 \_\_\_\_\_ miles \_\_\_\_\_ of \_\_\_\_\_  
 (distance) (direction) (nearest town)

WELL PURPOSE:  
 (home, irrigation, municipal, industrial)

- WELL COMPLETION DATA:
- (1) diameter (inches) 4 1/2
  - (2) total depth (feet) 48
  - (3) static water level (feet) 34 ~~below~~ <sup>above</sup> top of ground.
  - (4) casing \_\_\_\_\_ (material) \_\_\_\_\_ (depth) \_\_\_\_\_ (size) if telescope see back.
  - (5) screen 5 \_\_\_\_\_ (length) \_\_\_\_\_ (depth to top) 43  
2 \_\_\_\_\_ (size) \_\_\_\_\_ (material) PVC
  - (6) pump 1/2 \_\_\_\_\_ (HP) \_\_\_\_\_ (yield gpm) 4  
Sheer \_\_\_\_\_ (type power)
  - (7) electric log no \_\_\_\_\_ (yes or no)
  - \_\_\_\_\_ (organization running log)
  - (8) how well bottom plugged \_\_\_\_\_  
BW Valve


**CODED**

DRILLERS REMARKS:

MAY 29 1973  
 MISS. S.  
 MAY 29 1973

If well telescopes please sketch and show depths.

GROUND LEVEL

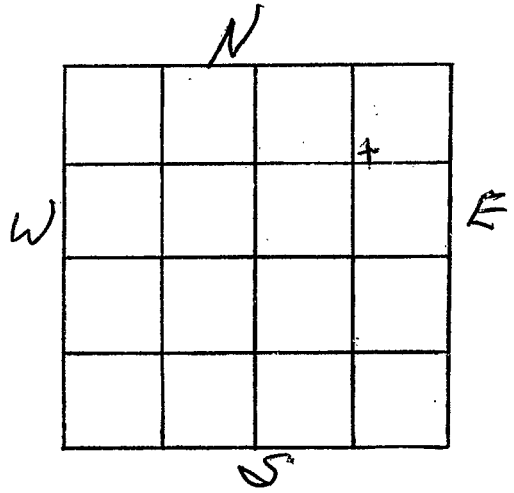

SECTION 2

Please indicate well location X.

ADDITIONAL INFORMATION

If more than one screen, show locations of each on sketch.