

Pearl River
F 42
12-22-73

MISSISSIPPI
BOARD OF WATER COMMISSIONERS
416 North State Street
Jackson, Mississippi 39201

CODED

WATER WELL DRILLERS LOG

12-22-73
date well completed

Earl Penton Waterwell Ser. Pearl River
firm name county well located

LANDOWNER:	description of formations encountered	from	to
Anthony Bertucci	Red clay	0	30'
Rt. 3 P.O. Parville Miss (mailing address)	Coarse white sd.	30	60'
WELL LOCATION:	Blue clay	60	140
sec. 7 T. 2 N. R. 16 E.	Fine Blue sd.	140	150
6 miles West of Tallonia (distance) (direction) (nearest town)	Blue clay	150	160
WELL PURPOSE: Home (home, irrigation, municipal, industrial)	Coarse Blue sd.	160	192
WELL COMPLETION DATA:			
(1) diameter (inches) 7 5/8"			
(2) total depth (feet) 192			
(3) static water level (feet) 137 below top of ground			
(4) casing P.V.C. 1.72' (material) (depth)			
4" (size) if telescope see back.			
(5) screen 30' 1.72' (length) (depth to top)			
4" (size) P.V.C. (material)			
(6) pump 3 (HP) 1147 Perks (yield gpm)			
Elect (type power)			
(7) electric log NO (yes or no)			
(organization running log)			
(8) how well bottom plugged Slope			

CODED


APR 13 1974

DRILLERS REMARKS:

MISS. Bd. of Water Comm.

If well telescopes please sketch and show depths.

GROUND LEVEL

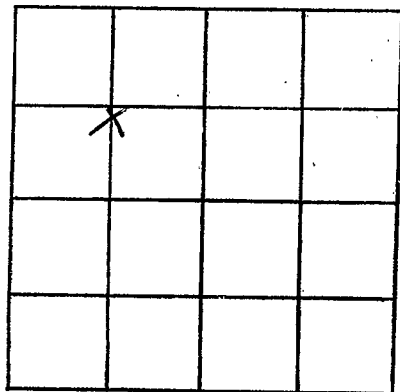

SECTION 7

Please indicate well location X.

ADDITIONAL INFORMATION

If more than one screen, show locations of each on sketch.