


PEARL RIVER  
F 44

MISSISSIPPI  
BOARD OF WATER COMMISSIONERS  
416 North State Street  
Jackson, Mississippi 39201

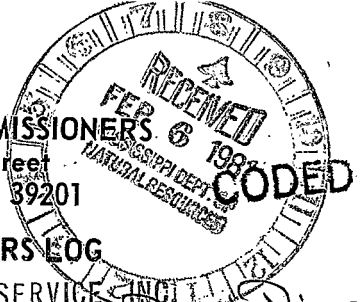

WATER WELL DRILLERS LOG

11-17-80

11-17-80

date well completed

BRADEN PUMP AND WELL SERVICE

firm name

county well located

LANDOWNER: John Smith  
Rt. 5, Box 250  
Poplarville, MS  
(mailing address)

description of formations encountered	from	to
Sand	0	10
Clay	10	20
Sand	20	25
Clay	25	200
Sand & clay	200	240
Sand	240	280

WELL LOCATION:  
sec 23 T 2 N R 16 E  
1/2 miles NW of Poplarville  
(distance) (direction) (nearest town)

WELL PURPOSE: home  
(home, irrigation, municipal, industrial)

WELL COMPLETION DATA:

(1) diameter (inches) 4"

(2) total depth (feet) 280'

(3) static water level (feet) 135' below top of ground.

(4) casing PVC total, (material) (depth)  
4" (size) if telescope see back.

(5) screen 20' 95' (length) (depth to top)  
4" PVC underbar (size) (material)

(6) pump 1/2 18 (HP) (yield gpm)  
230 (type power)

(7) electric log no (yes or no)


(organization running log)

(8) how well bottom plugged  
4" back wash valve

DRILLERS REMARKS:  
no tail pipe

If well telescopes please sketch and show depths.

GROUND LEVEL

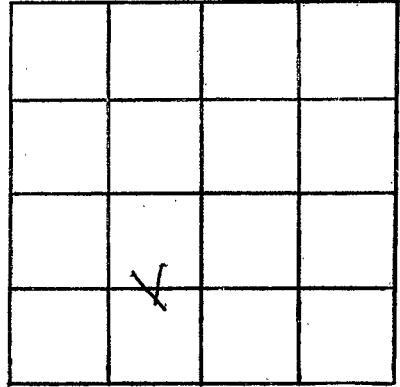

SECTION 23

Please indicate well location X.

ADDITIONAL INFORMATION

If more than one screen, show locations of each on sketch.