


PEARL RIVER
F45

MISSISSIPPI
BOARD OF WATER COMMISSIONERS
416 North State Street
Jackson, Mississippi 39201

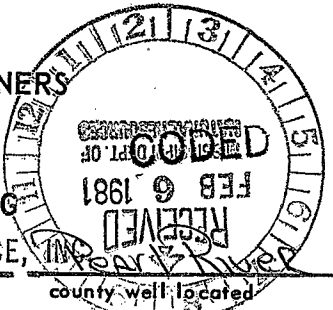

WATER WELL DRILLERS LOG

10-21-80

10-21-80
date well completed

BRADEN PUMP AND WELL SERVICE, INC.
firm name

county well located

LANDOWNER:
Webster E. Brown
Rt. 5, Box 284
Poplarville, MS
(mailing address)

description of formations encountered	depth	
	from	to
Clay	0	215
Sand	215	250
Clay	250	275
Sand	275	360

WELL LOCATION:
sec. 23 T. 2 N. R. 16 E.
S W
1 1/2 miles NW of Poplarville
(distance) (direction) (nearest town)

WELL PURPOSE: home
(home, irrigation, municipal, industrial)

- WELL COMPLETION DATA:
- (1) diameter (inches) 4" x 2"
 - (2) total depth (feet) 360
 - (3) static water level (feet) 100' below top of ground.
 - (4) casing Pvc, total
(material) (depth)
4" x 2" if telescope see back.
(size)
 - (5) screen 10', 330'
(length) (depth to top)
2", Pvc underbar
(size) (material)
 - (6) pump 1 1/2, 18
(HP) (yield gpm)
230
(type power)
 - (7) electric log no
(yes or no)
- (organization running log)
- (8) how well bottom plugged
2" sand shark

DRILLERS REMARKS:
20' tail pipe


If well telescopes please sketch and show depths.

GROUND LEVEL

4" x 40'
PC 1.5 in

4" x 40'
PC 1.5 in

4" x 40'
PC 1.5 in

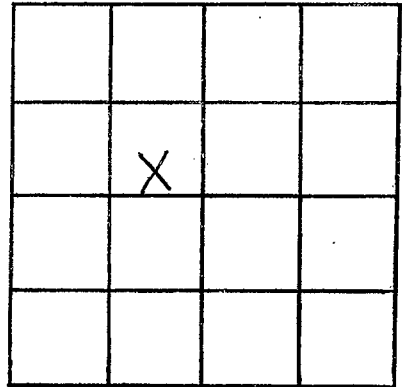

SECTION 23

Please indicate well location X.

ADDITIONAL INFORMATION

If more than one screen, show locations of each on sketch.