

MISSISSIPPI DEPARTMENT OF NATURAL RESOURCES

Bureau of Land and Water Resources

Southport Mall

P.O. Box 10631

CODED

Jackson, Mississippi 39209

WATER WELL DRILLERS LOG

Pearl River  
E 47  
3-12-85

3-12-85 date well completed      Griner Drilling Service, Inc. firm name      Pearl River county well located

| LANDOWNER:                                                                                                                                                                                         | description of formations encountered | from       | to         |
|----------------------------------------------------------------------------------------------------------------------------------------------------------------------------------------------------|---------------------------------------|------------|------------|
| <u>Exxon Co., U.S.A.</u><br><u>P.O. Box 53225</u><br><u>New Orleans, La. 70160</u><br>(mailing address)                                                                                            |                                       |            |            |
| <u>WELL LOCATION: 1642' S &amp; 1850' E</u><br><u>32' T 2' N R 16' E of</u><br><u>No. 2 Southern Minerals Co. Poplarville Field</u><br><u>1.5 miles (distance) S (direction) of (nearest town)</u> | <u>streaked</u>                       | <u>84</u>  | <u>105</u> |
| <u>WELL PURPOSE: oilfield supply</u><br>(home, irrigation, municipal, industrial)                                                                                                                  | <u>fine sand</u>                      | <u>105</u> | <u>147</u> |
| <u>WELL COMPLETION DATA:</u><br><u>2-4" water well on location</u><br>diameter (inches) <u>4"</u><br>total depth (feet) <u>336'</u>                                                                | <u>streaked</u>                       | <u>147</u> | <u>220</u> |
| (3) static water level (feet) <u>60'</u> <u>below</u> above top of ground.                                                                                                                         | <u>SAND</u>                           | <u>220</u> | <u>336</u> |
| (4) casing <u>steel</u> , <u>336'</u><br>(material) (depth)<br><u>4"</u> if telescope see back.<br>(size)                                                                                          |                                       |            |            |
| (5) screen <u>42'</u> , <u>294'</u><br>(length) (depth to top)<br><u>4" perforated</u><br>(size) (material)                                                                                        |                                       |            |            |
| (6) pump <u>-</u> <u>80</u><br>(HP) (yield gpm)<br><u>AC</u><br>(type power)                                                                                                                       |                                       |            |            |
| (7) electric log <u>(yes or no)</u><br>(organization running log)                                                                                                                                  |                                       |            |            |
| (8) how well bottom plugged <u>orange peel</u>                                                                                                                                                     |                                       |            |            |

Two wells - both 4" Airlift waters well Information same.


**RECEIVED**  
 MAR 25 1985

Department of Natural Resources  
 Bureau of Land & Water Resources

DRILLERS REMARKS:

If well telescopes please sketch and show depths.

GROUND LEVEL

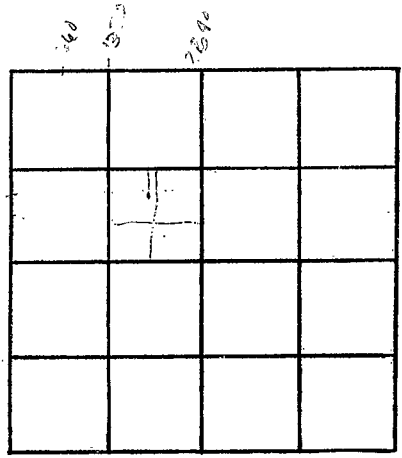

SECTION \_\_\_\_\_

Please indicate well location X.

**ADDITIONAL INFORMATION**

If more than one screen,  
show locations of each on sketch.