

MISSISSIPPI DEPARTMENT OF NATURAL RESOURCES

Bureau of Land and Water Resources

Southport Mall

P.O. Box 10631

Jackson, Mississippi 39209

WATER WELL DRILLERS LOG

Griner Drilling Service, Inc.

Pearl River

2-3-87 date well completed

firm name

county well located

LANDOWNER:

EXXON Company USA
P.O. Box 60006
New Orleans, La.

description of formations encountered

from

to

CLAY

0 65

SAND, pea gravel

65 140

CLAY, + SAND

140 415

SAND, pea gravel

415 530

CLAY

530 565

WELL LOCATION:

2284' S + 1532' E

sec. 31 T. 2 N. R. 16 E of

No. 6 Southern Minerals (S) Poplarville (W) NW corner (direction) of (nearest town)

WELL PURPOSE: oilfield rig supply

WELL COMPLETION DATA:

- (1) diameter (inches) 4"
- (2) total depth (feet) 565'
- (3) static water level (feet) 72' ^{below} top of ground.
- (4) casing steel 546' (material) (depth)
4" (size) if telescope see back.
- (5) screen 20' (length), 526' (depth to top)
4" (size), stainless steel (material)
- (6) pump 5 (HP), 85 (yield gpm)
230 volt 3 phase (type power)
- (7) electric log NO (yes or no)

CODED

Well No. 1 ON location

RECEIVED

MAY 13 1987

(organization running log)


4" Backwash orange peat valve

Department of Natural Resources
Bureau of Land & Water Resources

DRILLERS REMARKS:

If well telescopes please sketch and show depths.

GROUND LEVEL

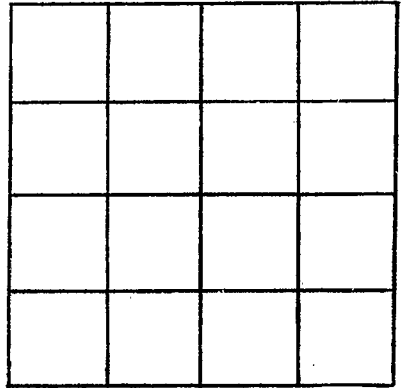

SECTION _____

Please indicate well location X.

ADDITIONAL INFORMATION

If more than one screen,
show locations of each on sketch.