

Pearl River
F 50

MISSISSIPPI DEPARTMENT OF NATURAL RESOURCES
 Bureau of Land and Water Resources
 Southport Mall
 P.O. Box 10631
 Jackson, Mississippi 39209

CODED

WATER WELL DRILLERS LOG

Griner Drilling Service, Inc.

Pearl River

2-3-87
 date well completed

firm name

county well located

| LANDOWNER: | description of formations encountered | from | to |
|--|---------------------------------------|------|-----|
| EXXON Company U.S.A. P.O. Box 60006 New Orleans, LA. (mailing address) | clay | 0 | 65 |
| WELL LOCATION: 2284 1/2 + 1532 1/2 E sec. 31 T. 2 N. R. 16 E of No. 6 Southern Minerals Poplarville, Miss. NW COR (direction) (nearest town) | SAND, pea gravel | 65 | 140 |
| WELL PURPOSE: <u>oilfield rig supply</u> (home, irrigation, mining industrial) | clay, sand | 140 | 415 |
| WELL COMPLETION DATA: | SAND, pea gravel | 415 | 550 |
| (1) diameter (inches) <u>4"</u> | clay | 550 | 565 |
| (2) total depth (feet) <u>565'</u> | | | |
| (3) static water level (feet) <u>72'</u> ^{below} top of ground. | | | |
| (4) casing <u>steel, 546'</u> (material) (depth) | | | |
| <u>4"</u> (size) if telescope see back. | | | |
| (5) screen <u>42'</u> , <u>504'</u> (length) (depth to top) | | | |
| <u>4"</u> <u>perforated</u> (size) (material) | | | |
| (6) pump <u>—</u> <u>85</u> (HP) (yield gpm) | | | |
| <u>AC</u> (type power) | | | |
| (7) electric log <u>(yes or no)</u> | | | |
| (organization running log) | | | |
| (8) how well bottom plugged <u>orange</u> | | | |
| <u>peel</u> | | | |
| DRILLERS REMARKS: | | | |


RECEIVED

MAY 13 1987

Department of Natural Resources
 Bureau of Land & Water Resources

If well telescopes please sketch and show depths.

GROUND LEVEL

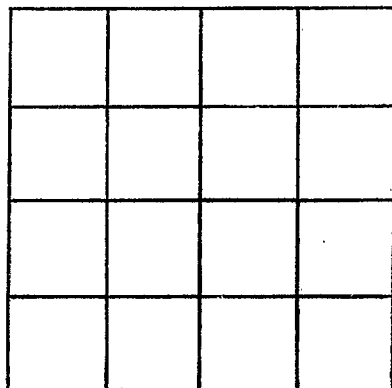

SECTION _____

Please indicate well location X.

ADDITIONAL INFORMATION

If more than one screen,
show locations of each on sketch.