

MISSISSIPPI DEPARTMENT OF NATURAL RESOURCES

Bureau of Land and Water Resources

Southport Mall

P.O. Box 10631

Jackson, Mississippi 39209

CODED

WATER WELL DRILLERS LOG

Griner Drilling Service, Inc.

Pearl River

Pearl River
F 51

6-12-87

date well completed

firm name

county well located

LANDOWNER:	description of formations encountered	from	to
EXXON CO., U.S.A. P.O. BOX 4301 Houston, TX. 77210-4301 (mailing address)	CLAY, SAND	0	21'
	CLAY	21'	415'
WELL LOCATION: 2400' N + 1909' W sec. 19 T 2 N R 16 E of No. 1 Poplarville Field southern minerals corp (direction) (nearest town)	SAND, pea gravel	415'	570'
WELL PURPOSE: oilfield supply (home, irrigation, municipal, industrial)			
WELL COMPLETION DATA:			
(1) diameter (inches) 4"			
(2) total depth (feet) 570'			
(3) static water level (feet) 43' below top of ground.	No. 1 water		
(4) casing steel 570' 4" (material) (depth) 4" (size) if telescope see back.	Well drilled		
(5) screen 20' 550' 4" (length) (depth to top) 4" stainless (size) (material) steel	on location		
(6) pump 5 HP 90 (yield gpm) 230 volt 3 phase (type power)			
(7) electric log (yes or no) Griner Drilling Service, Inc. (organization running log)			
(8) how well bottom plugged 4" back wash valve			
DRILLERS REMARKS:			


RECEIVED

JUL 9 1987

Department of Natural Resources
Bureau of Land & Water Resources

If well telescopes please sketch and show depths.

GROUND LEVEL

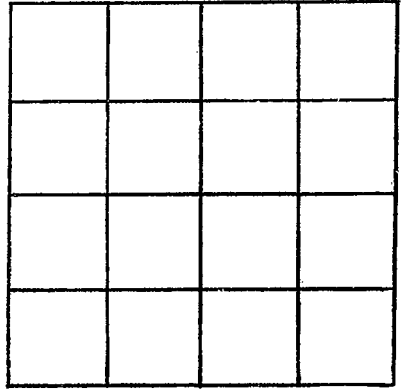

SECTION _____

Please indicate well location X.

ADDITIONAL INFORMATION

If more than one screen,
show locations of each on sketch.