

MISSISSIPPI DEPARTMENT OF NATURAL RESOURCES

Bureau of Land and Water Resources

Southport Mall

P.O. Box 10631

Jackson, Mississippi 39209

WATER WELL DRILLERS LOG **CODED**

Griner Drilling Service, Inc.

Pearl River

PEARL RIVER
F 52

6-12-87

firm name

county well located

LANDOWNER:
Exxon Company USA
P.O. Box 4301
Houston, TX 77210-4301
(mailing address)

description of formations encountered	from	to
<i>clay, SAND</i>	<i>0</i>	<i>21</i>
<i>clay</i>	<i>21</i>	<i>415</i>
<i>SAND, pea gravel</i>	<i>415</i>	<i>570</i>

WELL LOCATION: *2400 N + 1909 W*
sec 19 T 2 N R 16 E of
No. 1 Poplarville Field
South of Poplarville, Field
(direction) of (nearest town)

WELL PURPOSE: *oilfield supply*
(home, irrigation, municipal, industrial)

CODED

WELL COMPLETION DATA:

- (1) diameter (inches) *4"*
- (2) total depth (feet) *570'*
- (3) static water level (feet) *43'* below top of ground.
- (4) casing *steel 570'*
(material) (depth)
4"
(size) if telescope see back.
- (5) screen *42' 528'*
(length) (depth to top)
4" perforated
(size) (material)
- (6) pump *90-100*
(HP) (yield gpm)
AC
(type power)
- (7) electric (yes or no)

No. 2
under well
on location

RECEIVED

JUL 9 1987

Department of Natural Resources
Bureau of Land & Water Resources


(organization running log)

(8) how well bottom plugged *ORANGE*
peel

DRILLERS REMARKS:

If well telescopes please sketch and show depths.

GROUND LEVEL

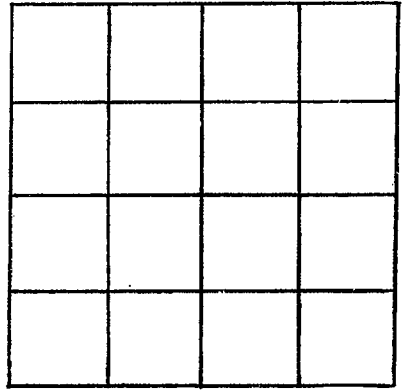

SECTION _____

Please indicate well location X.

ADDITIONAL INFORMATION

If more than one screen,
show locations of each on sketch.