

MISSISSIPPI DEPARTMENT OF NATURAL RESOURCES

Bureau of Land and Water Resources

Southport Mall

P.O. Box 10631

Jackson, Mississippi 39209

WATER WELL DRILLERS LOG

Griner Drilling Service, Inc.

Pearl River

PEARL RIVER
 F 754
 9-5-87

CODED

9-5-87 date well completed Griner Drilling Service, Inc. firm name Pearl River county well located

LANDOWNER:	description of formations encountered	from	to
Exxon company USA P.O. Box 4301 Houston, Texas 77210-4301 (mailing address)	clay, rock, sand	0	579
WELL LOCATION: 1606' N + 1685' E of sec. 29 T 2 N R 16 E S 10 W sub 10 No. 12 Southern Minerals Corp. Paplarville Field (direction) (nearest town)	sand, gravel	579	651
WELL PURPOSE: oilfield rig supply (home, irrigation, municipal, industrial)	clay	651	656
WELL COMPLETION DATA:	1606' N and 1685' E / SW corner		
(1) diameter (inches) 4"	No. 1 Water Well		
(2) total depth (feet) 656'			
(3) static water level (feet) 100' below top of ground.			
(4) casing steel, 609' (material) (depth) 4" (size) If telescope see back.			
(5) screen 20" 589' (length) (depth to top) 4" stainless (size) (material)			
(6) pump 5 100 (HP) (yield gpm) 230 volt 3 phase (type power)			
(7) electric log (yes or no) Griner Drilling Service (organization)			
(8) how well bottom plugged 4" backwash valve			
DRILLERS REMARKS:			


RECEIVED

OCT 19 1987

Department of Natural Resources
 Bureau of Land & Water Resources

If well telescopes please
sketch and show depths.

GROUND LEVEL

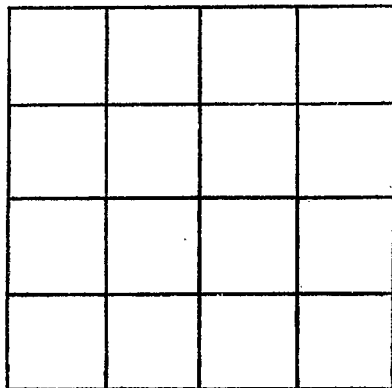

SECTION _____

Please indicate well location X.

ADDITIONAL INFORMATION

If more than one screen,
show locations of each on sketch.