

MISSISSIPPI DEPARTMENT OF NATURAL RESOURCES

Bureau of Land and Water Resources

Southport Mall

P.O. Box 10631

Jackson, Mississippi 39209

CODED

WATER WELL DRILLERS LOG

Griner Drilling Service, Inc. Pearl River

PEARL RIVER
RF 55
7-30-87

7-30-87 date well completed

Griner Drilling Service, Inc. firm name

Pearl River county well located

LANDOWNER:

EXXON Company USA

P.O. Box 4301
Houston, TX. 77210-4301
(mailing address)

description of formations encountered

from

to

SAND, clay 0 84

clay, little sand 84 180

WELL LOCATION: 1597'S & 1526'E

33 T 2 N R 16 E of
No. 11 Southern National Field (oil field)
Poplarville (nearest town)

SAND, pea gravel 180 260

clay streaks 260 357

WELL PURPOSE: Diff. field rig (home, irrigation, municipal, industrial)

SAND, gravel 357 462

WELL COMPLETION DATA:

clay 462 475

(1) diameter (inches) 4"

SAND, gravel 475 525

(2) total depth (feet) 537'

(3) static water level (feet) 65' below top of ground.

clay 525 537

(4) casing steel 525' (material) (depth)

4" (size) if telescope see back.

(5) screen 20' 505' (length) (depth to top)

No. 1 Water

4" stainless steel (size)

Well

(6) pump 5 80 (HP) (yield gpm)

230 volt 3 phase (type power)

RECEIVED

(7) electric log (yes or no)

SEP 21 1987

Griner Drilling Service, Inc. (organization, logging log)


(8) how well bottom plugged 4" backwash valve

Department of Natural Resources Bureau of Land & Water Resources

DRILLERS REMARKS:

If well telescopes please sketch and show depths.

GROUND LEVEL

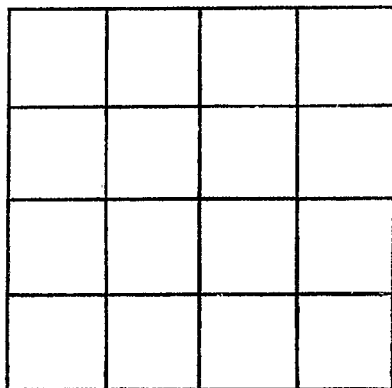

SECTION _____

Please indicate well location X.

ADDITIONAL INFORMATION

If more than one screen,
show locations of each on sketch.