

MISSISSIPPI DEPARTMENT OF NATURAL RESOURCES

Bureau of Land and Water Resources **CODED**

Southport Mall

P.O. Box 10631

Jackson, Mississippi 39209

WATER WELL DRILLERS LOG

Griner Drilling Service, Inc.

Pearl River

Pearl River
RF 56
7-30-87

7-30-87
date well completed

firm name

county well located

LANDOWNER:

EXXON Company USA

P.O. Box 4301

Houston, Tx. 77210-4301

(mailing address)

description of formations encountered

from

to

clay, sand

0 84

clay, little streaked

84 195

sand, pea gravel

195 250

streaked

250 357

sand, pea gravel

357 460

clay

460 475

sand, pea gravel

475 525

WELL LOCATION: 15975 + 1526 E

33 T 2 N R 16 of

s.c. 11 Southern Minerals

Poplarville Field

(direction) (nearest town)

WELL PURPOSE: oilfield rrg

(home, irrigation, municipal, industrial)

WELL COMPLETION DATA:

(1) diameter (inches)

4"

(2) total depth (feet)

525'

(3) static water level (feet)

65' below

top of ground.

(4) casing

steel, 525'

(material) (depth)

4"

(size) if telescope see back.

(5) screen

42' 483'

(length) (depth to top)

4"

(size) (material)

perforated

(6) pump

80

(HP) (yield gpm)

AC

(type power)

(7) electric log

(yes or no)

(organization running log)

(8) how well bottom plugged

ORANGE peel

DRILLERS REMARKS:


RECEIVED

SEP 21 1987

Department of Natural Resources
Bureau of Land & Water Resources

If well telescopes please
sketch and show depths.

GROUND LEVEL

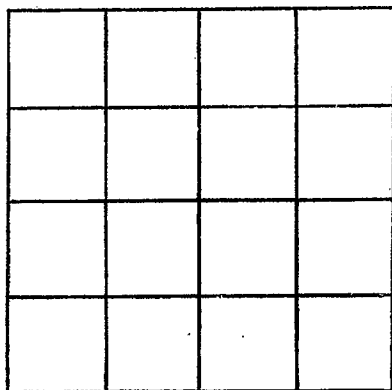

SECTION _____

Please indicate well location X.

ADDITIONAL INFORMATION

If more than one screen,
show locations of each on sketch.