

MISSISSIPPI DEPARTMENT OF NATURAL RESOURCES

Bureau of Land and Water Resources

Southport Mall

P.O. Box 10631

Jackson, Mississippi 39209

WATER WELL DRILLERS LOG

Pearl River  
F58  
4-17-88

Coded

Griner Drilling Service, Inc. Pearl River

4-17-88 date well completed

Griner Drilling Service, Inc. firm name

Pearl River county well located

LANDOWNER:

EXXON Company USA  
P.O. Box 4301  
New Orleans Division  
Houston, TX 77210

description of formations encountered

from

to

WELL LOCATION: 2949' N + 2093' W  
T 2 N R 16 E of Poplarville Field  
No. 2 Water Well  
Southern Minerals Corp. (distance) miles (direction) of (nearest town)

clay, sand

0 20

clay

20 90

clay, sand

90 305

sand

305 420

clay, sand

420 500

sand


500 588

WELL PURPOSE: oilfield rig supply  
(home, irrigation, municipal, industrial)

WELL COMPLETION DATA:

- (1) diameter (inches) 4"
- (2) total depth (feet) 588'
- (3) static water level (feet) 100' below top of ground.
- (4) casing steel 588' (material) (depth)  
4" (size) If telescope see back.
- (5) screen 20' 568' (length) (depth to top)  
4" stainless steel (size) (material)
- (6) pump 5 70 (HP) (yield gpm)  
230 volt 3 phase (type power)
- (7) electric log (yes or no)  
Griner Drilling Service (organization running log)
- (8) how well bottom plugged 4" backwash valve

No. 2 Water Well

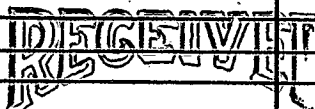


MAY 20 1988

Department of Natural Resources  
Bureau of Land & Water Resources

DRILLERS REMARKS:

If well telescopes please sketch and show depths.

GROUND LEVEL

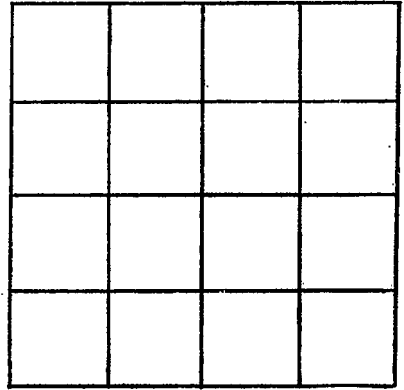

SECTION \_\_\_\_\_

Please indicate well location X.

ADDITIONAL INFORMATION

If more than one screen, show locations of each on sketch.