

Pearl River  
 F 2000  
 6-68

MISSISSIPPI  
 BOARD OF WATER COMMISSIONERS  
 416 North State Street  
 Jackson, Mississippi 39201

WATER WELL DRILLERS LOG

June 1 1968 Leo Zahner Pearl River  
 date well completed firm name county well located

LANDOWNER: IRETON  
 Poplarville Miss  
 (mailing address)

description of formations encountered	from	to
	Surface	0
Red clay	1	12
red sand	12	26
clay	26	330
sand	330	376

WELL LOCATION:  
 sec. 10 T 2 S R 16 E  
 4 miles NW of Poplarville  
 (distance) (direction) (nearest town)

WELL PURPOSE: Home  
 (home, irrigation, municipal, industrial)


- WELL COMPLETION DATA:
- (1) diameter (inches) 2"
  - (2) total depth (feet) 276
  - (3) static water level (feet) 130 below top of ground.
  - (4) casing Galv 272  
 (material) (depth)
  - (size) If telescope see back.
  - (5) screen 4" 272  
 (length) (depth to top)  
 2 55.  
 (size) (material)
  - (6) pump 3/4 1800PH  
 (HP) (yield gpm)  
 Rod Elec.  
 (type power)
  - (7) electric log (yes or no)  
 (organization running log)
  - (8) how well bottom plugged Bw take

JUL 23 1968  
 MISS. BOARD OF  
 WATER COMM.

DRILLERS REMARKS:

If well telescopes please sketch and show depths.

GROUND LEVEL

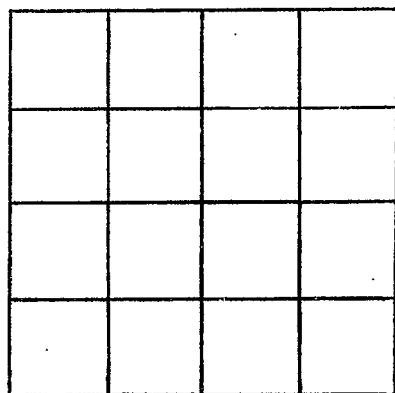

SECTION \_\_\_\_\_

Please indicate well location X.

ADDITIONAL INFORMATION

If more than one screen, show locations of each on sketch.