

Pearl River

F 2001

10-23-75

MISSISSIPPI BOARD OF WATER COMMISSIONERS
416 North State Street
Jackson, Mississippi 39201

135

WATER WELL DRILLERS LOG

10/23/75
date well completed

Stafford Wells Co.
firm name

Pearl River County
county well located

LANDOWNER:
David Seal
Poplarville Miss
(mailing address)


description of formations encountered	from	to
top soil	0	5
clay & sand	5	20
chalk	40	65
sandy pebbles	65	95

WELL LOCATION:
sec. 1 T. 2 N. R. 16 E.
S W
2 miles north of Poplarville
(distance) (direction) (nearest town)

WELL PURPOSE: Home
(home, irrigation, municipal, industrial)


- WELL COMPLETION DATA:
- (1) diameter (inches) 4"
 - (2) total depth (feet) 95
 - (3) static water level (feet) 80 below top of ground.
 - (4) casing plastic, 95 (material) (depth)
4" (size) if telescope see back.
 - (5) screen 10ft., 85ft. (length) (depth to top)
4" (size) plastic (material)
 - (6) pump 1/2 hp, 10 (HP) (yield gpm)
elect. (type power)
 - (7) electric log (yes or no)
 - (organization running log)
 - (8) how well bottom plugged B.W.V.

DRILLERS REMARKS:
Salvage Opened

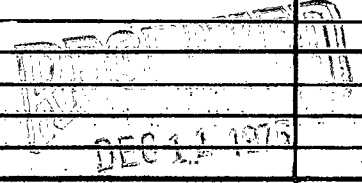

If well telescopes please sketch and show depths.

GROUND LEVEL

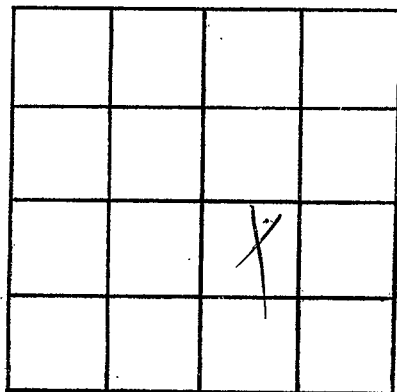

SECTION 1

Please indicate well location X.

ADDITIONAL INFORMATION

If more than one screen,
show locations of each on sketch.