

Pearl River  
F 2002  
7/22/76

MISSISSIPPI  
 BOARD OF WATER COMMISSIONERS  
 416 North State Street  
 Jackson, Mississippi 39201

WATER WELL DRILLERS LOG

7-22 1976 Griner - Ginn Pearl River  
 date well completed firm name county well located

LANDOWNER:  
David Wallace  
Rt. 4, Box 487 Poplarville,  
 (mailing address) Miss.

WELL LOCATION:  
 sec. 34 T 2 N R 16 E  
1/2 miles NW of Poplarville  
 (distance) (direction) (nearest town)

WELL PURPOSE: Home  
 (home, irrigation, municipal, industrial)

WELL COMPLETION DATA:

(1) diameter (inches) 4"

(2) total depth (feet) 325'

(3) static water level (feet) 150' below above top of ground.

(4) casing PVC, 310'  
 (material) (depth)  
4" if telescope see back.  
 (size)

(5) screen 10', 310'  
 (length) (depth to top)  
4", PVC  
 (size) (material)

(6) pump 3/4 119 gpm  
 (HP) (yield gpm)  
elec.  
 (type power)

(7) electric log NO  
 (yes or no)

(organization running log)

(8) how well bottom plugged B.W. Valve

description of formations encountered	from	to
<u>Top Soil</u>	<u>0</u>	<u>1</u>
<u>Clay</u>	<u>1</u>	<u>19</u>
<u>CHALK</u>	<u>19</u>	<u>84</u>
<u>CHALK &amp; SAND</u>	<u>84</u>	<u>130</u>
<u>SAND</u>	<u>130</u>	<u>137</u>
<u>CHALK</u>	<u>137</u>	<u>286</u>
<u>SAND</u>	<u>286</u>	<u>325</u>


DRILLERS REMARKS:

**RECEIVED**  
 OCT 12 1976

MISS. BD. OF WATER COMMISSIONERS

If well telescopes please sketch and show depths.

GROUND LEVEL

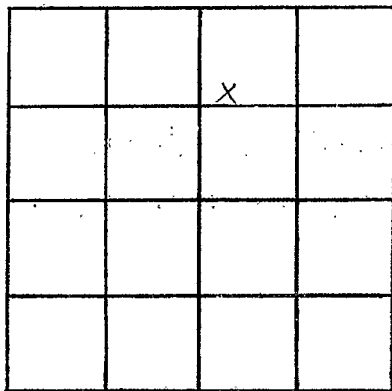

SECTION 24

Please indicate well location X.

ADDITIONAL INFORMATION

If more than one screen,  
show locations of each on sketch.