

PEARL RIVER
 F 2003
 1-14-76

MISSISSIPPI
 BOARD OF WATER COMMISSIONERS
 416 North State Street
 Jackson, Mississippi 39201

13V

WATER WELL DRILLERS LOG

1/14 1976 Bud Martin & Sons Pearl River
 date well completed firm name county well located

LANDOWNER: Thas & J Koch
Poplarville Miss.
Rt. Box 207
 (mailing address)

description of formations encountered	from	to
Red shale	0	75
Red sand	75	93
white sand	93	195
blue shale	195	260
white sand	260	287

WELL LOCATION:
 sec. 13 T 2 N R. 16 E
 (S) (W)
2 miles north of Poplarville
 (distance) (direction) (nearest town)

WELL PURPOSE: home
 (home, irrigation, municipal, industrial)

- WELL COMPLETION DATA:
- diameter (inches) 2"
 - total depth (feet) 287
 - static water level (feet) 121 below top of ground.
 - casing low, 277
 (material) (depth)
2" if telescope see back.
 (size)
 - screen 2x10, 277
 (length) (depth to top)
12, 1/2" steel
 (size) (material)
 - pump 1 1/2, 2650 gpm
 (HP) (yield gpm)
elect
 (type power)
 - electric log no
 (yes or no)
- (organization running log)
- (8) how well bottom plugged Sound shock


DRILLERS REMARKS:



APR 12 1976

If well telescopes please sketch and show depths.

GROUND LEVEL

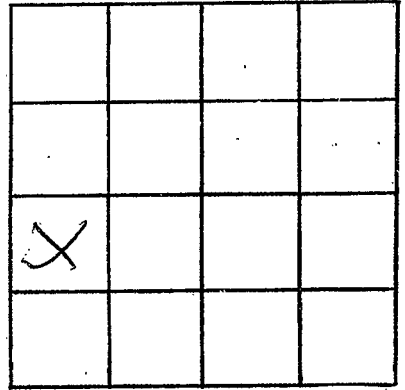

SECTION _____

Please indicate well location X.

ADDITIONAL INFORMATION

If more than one screen,
show locations of each on sketch.