

Pearl River
F 2005
3-17-77

MISSISSIPPI
 BOARD OF WATER COMMISSIONERS
 416 North State Street
 Jackson, Mississippi 39201

13V

WATER WELL DRILLERS LOG

3-17 1977 Bud Denton Pearl River
 date well completed firm name county well located

LANDOWNER:
Water Adles
Poplarville, Miss.
 (mailing address)

description of formations encountered	from	to
<u>Red shale</u>	<u>0</u>	<u>29</u>
<u>White sand</u>	<u>29</u>	<u>35</u>
<u>White shale</u>	<u>35</u>	<u>360</u>
<u>Blue sand</u>	<u>360</u>	<u>385</u>

WELL LOCATION:
 sec. 22 T. 2 N R. 16 E
2 1/2 miles N.W. of Poplarville
 (distance) (direction) (nearest town)

WELL PURPOSE:
 (home, irrigation, municipal, industrial)

- WELL COMPLETION DATA:
- (1) diameter (inches) 2 in
 - (2) total depth (feet) 383
 - (3) static water level (feet) 126 below above top of ground.
 - (4) casing Galv., 317,
 (material) (depth)
 (size) if telescope see back.
 - (5) screen 6 ft., 317
 (length) (depth to top)
2 in., S. Steel
 (size) (material)
 - (6) pump 1 1/2, 350 m
 (HP) (yield gpm)
electric
 (type power)
 - (7) electric log no
 (yes or no)

(organization running log)


(8) how well bottom plugged
Sand Seal

DRILLERS REMARKS:

RECEIVED
 APR 15 1977

If well telescopes please sketch and show depths.

GROUND LEVEL

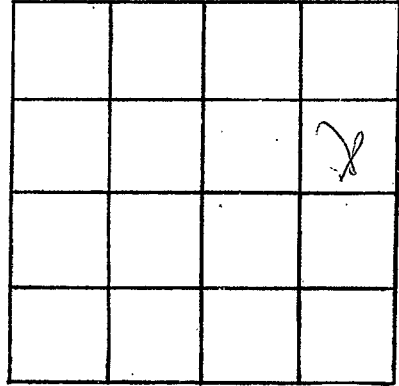

SECTION _____

Please indicate well location X.

ADDITIONAL INFORMATION

If more than one screen,
show locations of each on sketch.