

Pearl River
F 2006
3-22-77

MISSISSIPPI
 BOARD OF WATER COMMISSIONERS
 416 North State Street
 Jackson, Mississippi 39201

WATER WELL DRILLERS LOG

3-22 1977 Bud Benton Pearl River
 date well completed firm name county well located

LANDOWNER:
Joney Duval
 (mailing address)

WELL LOCATION:
 sec. 22 T. 2 N. R. 16 E.
 ? ? ? ? ?
 (distance) miles (direction) of (nearest town)

WELL PURPOSE: Home
 (home, irrigation, municipal, industrial)

WELL COMPLETION DATA:
 (1) diameter (inches) 4 in
 (2) total depth (feet) 348
 (3) static water level (feet) 131 below above top of ground.
 (4) casing PVC, 338,
 (material) (depth)
 (size) if telescope see back.
 (5) screen 10, 338
 (length) (depth to top)
4 in, PVC
 (size) (material)
 (6) pump 1 1/2, 600 w
 (HP) (yield gpm)
electric
 (type power)
 (7) electric log No
 (yes or no)
 (organization running log)

(8) how well bottom plugged
Sand Slack

DRILLERS REMARKS:


description of formations encountered	from	to
<u>Red shale</u>	<u>0</u>	<u>27</u>
<u>White sand</u>	<u>27</u>	<u>38</u>
<u>Gray shale</u>	<u>38</u>	<u>301</u>
<u>Sand</u>	<u>301</u>	<u>348</u>

RECEIVED
 APR 15 1977

MISS. BD. OF WATER COMM.

If well telescopes please sketch and show depths.

GROUND LEVEL

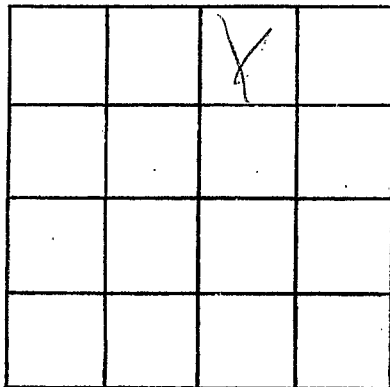

SECTION _____

Please indicate well location X.

ADDITIONAL INFORMATION

If more than one screen,
show locations of each on sketch.