

PEARL RIVER

F 2007

3/15/78

MISSISSIPPI BOARD OF WATER COMMISSIONERS 416 North State Street Jackson, Mississippi 39201

WATER WELL DRILLERS LOG

3/15 1978 date well completed Pearl River firm name Pearl River county well located

LANDOWNER: Merwin Lupton description of formations encountered Red Shale from 0 to 96 feet 200 to 220 (mailing address)

WELL LOCATION: sec. 22 T. 2 N R. 16 E (8) miles W of Pearl River (distance) (direction) (nearest town)

WELL PURPOSE: home (home, irrigation, municipal, industrial)

- WELL COMPLETION DATA: (1) diameter (inches) 2 (2) total depth (feet) 220 (3) static water level (feet) 53 below top of ground (4) casing PVC 2 1/2 (material) (depth) 20 if telescope see back. (size) (5) screen 2x10 2 1/2 (length) (depth to top) 2 1/2 (size) (material) (6) pump 1 (HP) 450 (yield gpm) Electric (type power) (7) electric log no (yes or no)


(organization running log) (8) how well bottom plugged Sand Shark

DRILLERS REMARKS:

RECEIVED JUL 14 1978

If well telescopes please sketch and show depths.

GROUND LEVEL

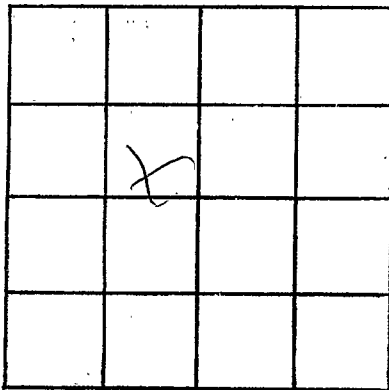

SECTION \_\_\_\_\_

Please indicate well location X.

ADDITIONAL INFORMATION

If more than one screen,  
show locations of each on sketch.