

PEARL RIVER

F 2008

9-11-78

MISSISSIPPI BOARD OF WATER COMMISSIONERS 416 North State Street Jackson, Mississippi 39201

WATER WELL DRILLERS LOG

9/11 date well completed 1978 Paul Penton Son Pearl River firm name county well located

LANDOWNER: Mack Lambert description of formations encountered from to B.T. 1 Box 74 D Gray shale 0 230 Poplarville Miss. Gray sand 230 268 (mailing address)


WELL LOCATION: sec. 2 T. 2 N. R. 16 E. 187 miles NW. of Poplarville (distance) (direction) (nearest town)

WELL PURPOSE: home (home, irrigation, municipal, industrial)

- WELL COMPLETION DATA: (1) diameter (inches) 4 (2) total depth (feet) 268 (3) static water level (feet) 73 below top of ground. (4) casing (material) PVC (depth) 258 (size) if telescope see back. (5) screen 4x10 (length) 258 (depth to top) 12 PVC (size) (material) (6) pump NO (HP) (yield gpm) NO (type power) (7) electric log NO (yes or no)

(organization running log) (8) how well bottom plugged


DRILLERS REMARKS: NO pump furnished

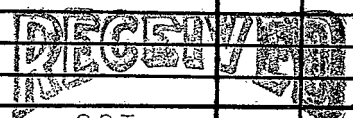

OCT 4 1978

If well telescopes please sketch and show depths.

GROUND LEVEL

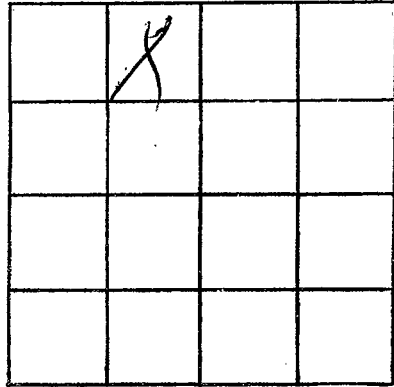

SECTION _____

Please indicate well location X.

ADDITIONAL INFORMATION

If more than one screen,
show locations of each on sketch.