

PEARL RIVER

F 2007

05-03-79

MISSISSIPPI BOARD OF WATER COMMISSIONERS 416 North State Street Jackson, Mississippi 39201

WATER WELL DRILLERS LOG

May 3, 1979 Dixie Water Well Pump, Inc. Pearl River date well completed firm name county well located

LANDOWNER: S. Murphy Trucking Inc. Marietta St. Chalmotte, La. 70043 (mailing address)

Table with 4 columns: description of formations encountered, from, to. Rows include White clay, fine sand, Blue clay, fine sand, coarse sand.

WELL LOCATION: sec. 21 T 2 N R 16 E 1/2 miles west of Bogalusa (distance) (direction) (nearest town)

WELL PURPOSE: none (home, irrigation, municipal, industrial)


- WELL COMPLETION DATA: (1) diameter (inches) 4" (2) total depth (feet) 25' (3) static water level (feet) 70 below top of ground. (4) casing P.V.C. 231' (material) (depth) 4" (size) If telescope see back. (5) screen 20' 251' (length) (depth to top) 4" (size) P.V.C. (material) (6) pump 1 20 (HP) (yield gpm) Electric (type power) (7) electric log 710 (yes or no) (organization running log) (8) how well bottom plugged sand shank

DRILLERS REMARKS:

Miss. Board of Water Comm. MAY 9 1979 RECEIVED

If well telescopes please sketch and show depths.

GROUND LEVEL

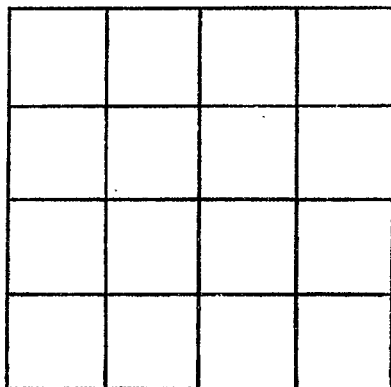

SECTION \_\_\_\_\_

Please indicate well location X.

ADDITIONAL INFORMATION

If more than one screen,  
show locations of each on sketch.