

PEARLE RIVER
F 2010
04-27-79

**MISSISSIPPI
BOARD OF WATER COMMISSIONERS**
416 North State Street
Jackson, Mississippi 39201

WATER WELL DRILLERS LOG

April 27, 1979 Dixie Water Well & Pump, Inc. Pearl River
 date well completed firm name county well located

LANDOWNER:
 Santa Maria Corp.
 (mailing address)

description of formations encountered	from	to
White Clay	0	25
Blue Clay	25	178
Gray Sand	178	254

WELL LOCATION:
 sec. 21 T. 2 S. R. 16 E.
 6 miles West of Poplarville
 (distance) (direction) (nearest town)

WELL PURPOSE: Home
 (home, irrigation, municipal, industrial)

- WELL COMPLETION DATA:**
- (1) diameter (inches) 4
 - (2) total depth (feet) 254
 - (3) static water level (feet) 70 below top of ground.
 - (4) casing P.V.C. 234
 (material) (depth)
 4" (size) If telescope see back.
 - (5) screen 20' 254
 (length) (depth to top)
 4" P.V.C.
 (size) (material)
 - (6) pump 1 20
 (HP) (yield gpm)
 Electric (type power)
 - (7) electric log No
 (yes or no)
- (organization running log)
- (8) how well bottom plugged
 Sand Shark

Miss. Board of Water Comm.


MAY - 7 1979

RECEIVED

DRILLERS REMARKS:

If well telescopes please sketch and show depths.

GROUND LEVEL

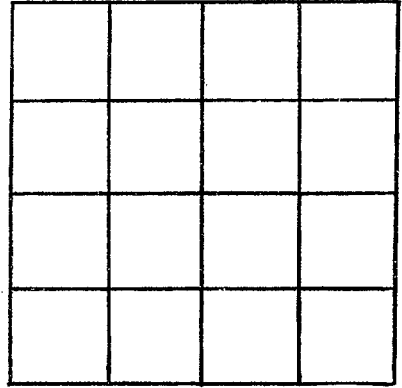

SECTION _____

Please indicate well location X.

ADDITIONAL INFORMATION

If more than one screen,
show locations of each on sketch.