

MISSISSIPPI DEPARTMENT OF NATURAL RESOURCES

Bureau of Land and Water Resources

Southport Mall

P.O. Box 10631

Jackson, Mississippi 39209

WATER WELL DRILLERS LOG

PEARL RIVER
F 2014
5/1/81

1981 81 Bend Ponton Pearl River firm name
date well completed Water Well Service county well located

LANDOWNER: Charles R. Boyer
po box poplarville
miss
(mailing address)

WELL LOCATION:
sec 27 T 2 N R 16 E
S W
3 miles West Poplarville
(distance) (direction) (nearest town)

WELL PURPOSE: none
(home, irrigation, municipal, industrial)

WELL COMPLETION DATA:


- (1) diameter (inches) 2"
- (2) total depth (feet) 480
- (3) static water level (feet) 110 below above top of ground.
- (4) casing PVC 480
(material) (depth)
- (size) If telescope see back.
- (5) screen 2x10 420
(length) (depth to top)
- (size) (material)
- (6) pump 1/2 420
(HP) (yield gpm)
- (type power) Elect
- (7) electric log no
(yes or no)

(organization running log)

(8) how well bottom plugged sand
2 ft

DRILLERS REMARKS:

description of formations encountered	from	to
white shaly	0	16
white sand	16	21
white shale	21	165
blue sand	165	220
blue shale	220	322
gray sand	322	360
blue shale	360	430
gray sand	430	480

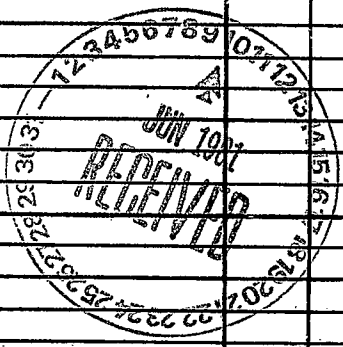

If well telescopes please sketch and show depths.

GROUND LEVEL

X			

SECTION _____

Please indicate well location X.

ADDITIONAL INFORMATION

If more than one screen,
show locations of each on sketch.