

PEARL RIVER
F 2017

MISSISSIPPI
BOARD OF WATER COMMISSIONERS
416 North State Street
Jackson, Mississippi 39201

4-23-81

WATER WELL DRILLERS LOG

4-23-81

BRADEN PUMP AND WELL SERVICE, INC

Pearl
RIVER
county well located

date well completed

firm name

county well located

LANDOWNER:
PAUL KROUSS

description of formations
encountered

from to

Rt. 2 Poplarville, MS
(mailing address)

CLAY
SAND
CLAY
SAND
CLAY
SAND

0 20
20 30
30 40
40 95
95 150
150 180

WELL LOCATION:

sec 23 T 2 N R 16 E
1 1/2 miles NW of Poplarville
(distance) (direction) (nearest town)

WELL PURPOSE: home
(home, irrigation, municipal, industrial)

WELL COMPLETION DATA:


- (1) diameter (inches) 2"
- (2) total depth (feet) 180'
- (3) static water level (feet) 55' ^{below} _{above} top of ground.
- (4) casing PVC, total 2" (material) (depth) if telescope see back.
- (5) screen 10' 170' (length) (depth to top) 2" PVC under bar (size) (material)
- (6) pump 1 (HP) 8 (yield gpm) 230 (type power)
- (7) electric log NO (yes or no)

(organization running log)

(8) how well bottom plugged 2" sand shark


DRILLERS REMARKS:

no tail pipe

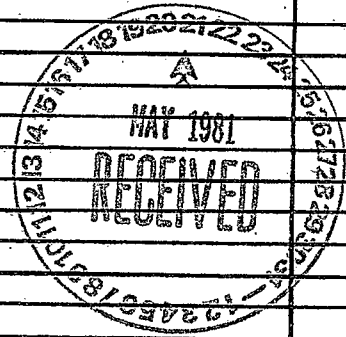

If well telescopes please sketch and show depths.

GROUND LEVEL

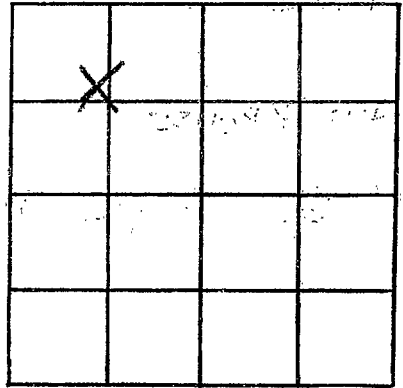

SECTION 23

Please indicate well location X.

ADDITIONAL INFORMATION

If more than one screen, show locations of each on sketch.