

Pearl River
F 2018
7-13-81

MISSISSIPPI
BOARD OF WATER COMMISSIONERS
416 North State Street
Jackson, Mississippi 39201

WATER WELL DRILLERS LOG
BRADEN PUMP AND WELL SERVICE, INC.
ROUTE 1, BOX 489
SAUCIER, MS ^{firm name} 39574

PEARL RIVER

7-13-81
date well completed

county well located

LANDOWNER:
DANNY FINCHER
6154 WARWICK CT
NEW ORLEANS LA 70114
(mailing address)

description of formations encountered	from	to
CLAY	0	20
SAND	20	35
CLAY	35	85
SAND	85	90
CLAY	90	95
SAND	95	120
CLAY	120	125
SAND	125	145
CLAY	145	160

WELL LOCATION:
sec. 26 T. 2 N R. 16 E
4 1/4 miles W of Poplarville
(distance) (direction) (nearest town)

WELL PURPOSE: home
(home, irrigation, municipal, industrial)


- WELL COMPLETION DATA:
- (1) diameter (inches) 2"
 - (2) total depth (feet) 160
 - (3) static water level (feet) SS below top of ground.
 - (4) casing PVC (material) total (depth)
2" (size) if telescope see back.
 - (5) screen 10' (length) 140' (depth to top)
2" (size) PVC underdrain (material)
 - (6) pump 1 (HP) 12 (yield gpm)
230 (type power)
 - (7) electric log no (yes or no)

(organization running log)

(8) how well bottom plugged
2" SAND SHARK

DRILLERS REMARKS:

10' + 1" PIPE

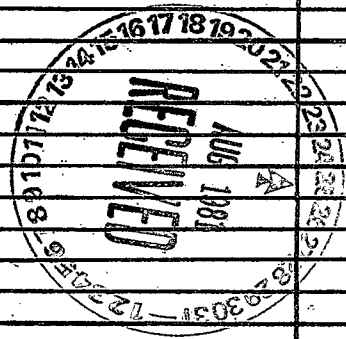


DEPT. OF NATURAL RESOURCES
BUREAU OF LAND & WATER RESOURCES

AUG 25 1981

RECEIVED

If well telescopes please sketch and show depths.

GROUND LEVEL

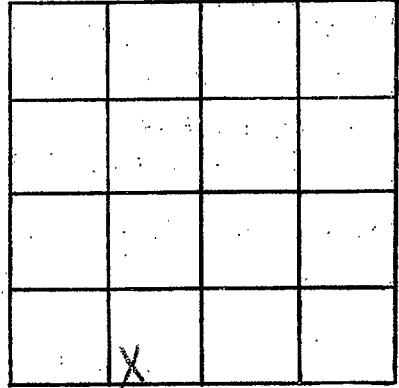

SECTION 26

Please indicate well location X.

ADDITIONAL INFORMATION

If more than one screen, show locations of each on sketch.