

MISSISSIPPI DEPARTMENT OF NATURAL RESOURCES

Bureau of Land and Water Resources

Southport Mall

P.O. Box 10631

Jackson, Mississippi 39209

WATER WELL DRILLERS LOG

Paul River
F 2000

19 Clear Water Drilling P. River
date well completed firm name county well located
Robert L Schmidt

LANDOWNER: NORMAN ODOM

description of formations encountered	from	to
coarse red	0'	20'
gravel coarse	20'	30
red clay	30	35
tan clay	35	85
med. tan sand & clay	85	97
med. tan sand	97	105

(mailing address)

WELL LOCATION:

sec. 23 T. 2 N. R. 16 E
3 miles SE of Poplarville
(distance) (direction) (nearest town)

WELL PURPOSE: HOME
(home, irrigation, municipal, industrial)

WELL COMPLETION DATA:

- (1) diameter (inches) 2"
- (2) total depth (feet) 105'
- (3) static water level (feet) 86' below above top of ground.
- (4) casing PVC, 95',
(material) (depth)
- If telescope see back.
(size)
- (5) screen 10', 95'
(length) (depth to top)
.010, PVC
(size) (material)
- (6) pump 2 7
(HP) (yield gpm)
220 AC
(type power)
- (7) electric log _____
(yes or no)


(organization running log)
- (8) how well bottom plugged
sand shark

DRILLERS REMARKS:

DEPT. OF NATURAL RESOURCES
BUREAU OF LAND & WATER RESOURCES
MAR 16 1982
RECEIVED

If well telescopes please sketch and show depths.

GROUND LEVEL

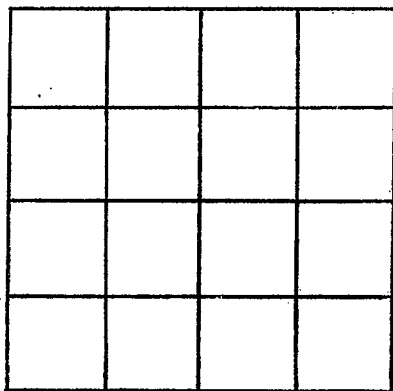

SECTION _____

Please indicate well location X.

ADDITIONAL INFORMATION

If more than one screen,
show locations of each on sketch.