

MISSISSIPPI DEPARTMENT OF NATURAL RESOURCES

Bureau of Land and Water Resources

Southport Mall

P.O. Box 10631

Jackson, Mississippi 39209

WATER WELL DRILLERS LOG

Pearl River
F 2023
8/12/82

8/12 1982 Close Water Drilling Pearl River
 date well completed firm name county well located

LANDOWNER: D WIGHT Wesley
411 N. JACKSON
POPLARVILLE, MS. 39470
 (mailing address)

description of formations encountered	from	to
TOP Soil	0	8"
yellow to Tan clay	8"	30'
Yellow Red Tan Clay Fine Sand	30'	40'
Finer MEP Sand fine clay	40'	80'
MEP & fine Red Sand	80'	180'

WELL LOCATION:
 sec. 31 T 2 N. R. 16 E
5 miles SW of Poplarville
 (distance) (direction) (nearest town)

WELL PURPOSE: hand
 (home, irrigation, municipal, industrial)

- WELL COMPLETION DATA:
- (1) diameter (inches) 2
 - (2) total depth (feet) 100
 - (3) static water level (feet) 52' below above top of ground.
 - (4) casing PVC 80
 (material) (depth)
 (size) if telescope see back.
 - (5) screen 20 50
 (length) (depth to top)
012 PVC
 (size) (material)
 - (6) pump 1 9
 (HP) (yield gpm)
115V
 (type power)
 - (7) electric log _____
 (yes or no)
 (organization running log)
 - (8) how well bottom plugged Small Shovel

DRILLERS REMARKS: _____


DEPT. OF NATURAL RESOURCES
 BUREAU OF LAND & WATER RESOURCES

SFP - 7 1982

RECEIVED

If well telescopes please
sketch and show depths.

GROUND LEVEL

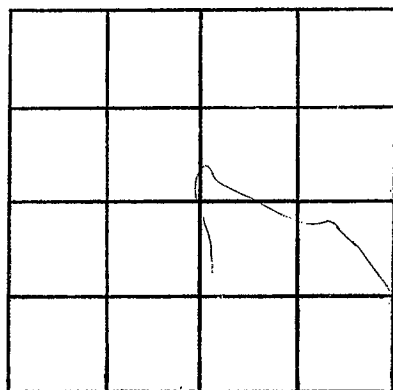

SECTION _____

Please indicate well location X.

ADDITIONAL INFORMATION

If more than one screen,
show locations of each on sketch.