

MISSISSIPPI DEPARTMENT OF NATURAL RESOURCES

Bureau of Land and Water Resources

Southport Mall

P.O. Box 10631

Jackson, Mississippi 39209

WATER WELL DRILLERS LOG

Pearl River  
F 20024  
5/12/83

5/12/83 date well completed  
Bradley Pump & Well Sew, Inc. firm name  
Pearl River county well located

LANDOWNER: Kermit Allen  
Rt. 2, Box 311C  
Poplarville, Ms. 39470  
(mailing address)

description of formations encountered	from	to
top soil - sand	0	15
blue clay	15	50
white clay	50	60
sand	60	130
clay	130	200
sand	200	240

WELL LOCATION:  
sec. 22 T-20N R-16E  
in Poplarville  
(distance) miles (direction) of (nearest town)

WELL PURPOSE: home  
(home, irrigation, municipal, industrial)

- WELL COMPLETION DATA:
- (1) diameter (inches) 4"
  - (2) total depth (feet) 240'
  - (3) static water level (feet) 30 below top of ground.
  - (4) casing PVC, 230 (material) (depth)  
4" (size) if telescope see back.
  - (5) screen 10' (length), 230 (depth to top)  
2" (size), PVC underbar (material)
  - (6) pump 1 (HP), 10 (yield gpm)  
230V (type power)
  - (7) electric log no (yes or no)  
(organization running log)
  - (8) how well bottom plugged 2" PVC  
Sandshank

DRILLERS REMARKS: no  
tail pipe


DEPT. OF NATURAL RESOURCES  
BUREAU OF LAND & WATER RESOURCES

MAY 16 1983

RECEIVED

If well telescopes please sketch and show depths.

GROUND LEVEL

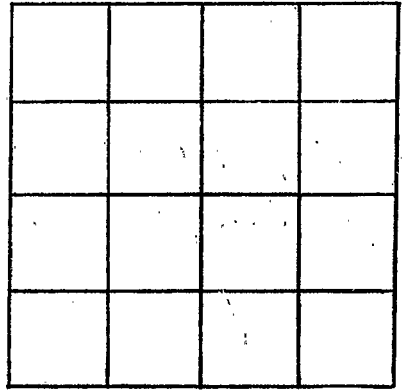

SECTION \_\_\_\_\_

Please indicate well location X.

ADDITIONAL INFORMATION

If more than one screen,  
show locations of each on sketch.