

MISSISSIPPI DEPARTMENT OF NATURAL RESOURCES

Bureau of Land and Water Resources

Southport Mall

P.O. Box 10631

Jackson, Mississippi 39209

WATER WELL DRILLERS LOG

Pearl River  
F 2025

May 1 1984 Walker Welllog Pearl River  
date well completed firm name county well located

LANDOWNER: John Juneau  
827 Crescent Blvd  
Hanna La  
(mailing address)

description of formations encountered	from	to
<u>Red sand shale</u>	<u>0</u>	<u>18</u>
<u>gravel</u>	<u>18</u>	<u>25</u>
<u>Blue shale</u>	<u>25</u>	<u>45</u>
<u>Brownish shale</u>	<u>45</u>	<u>85</u>
<u>Coarse sand gravel</u>	<u>85</u>	<u>130</u>

WELL LOCATION:  
sec. 8 T 2 R 16  
S W  
5 miles E Poplarville  
(distance) (direction) (nearest town)

WELL PURPOSE: Home  
(home, irrigation, municipal, industrial)

WELL COMPLETION DATA:

(1) diameter (inches) 2"

(2) total depth (feet) 130'

(3) static water level (feet) 74 below above top of ground.

(4) casing PVC, 120'  
(material) (depth)

(size) If telescope see back.

(5) screen 10', 120'  
(length) (depth to top)

10, PVC  
(size) (material)

(6) pump 1 10  
(HP) (yield gpm)

2hp  
(type power)

(7) electric log (yes or no) \_\_\_\_\_  
(organization running log) \_\_\_\_\_

(8) how well bottom plugged S.S.

DEPT. OF NATURAL RESOURCES  
BUREAU OF LAND & WATER RESOURCES


MAY 11 1984

RECEIVED

DRILLERS REMARKS: \_\_\_\_\_

If well telescopes please sketch and show depths.

GROUND LEVEL

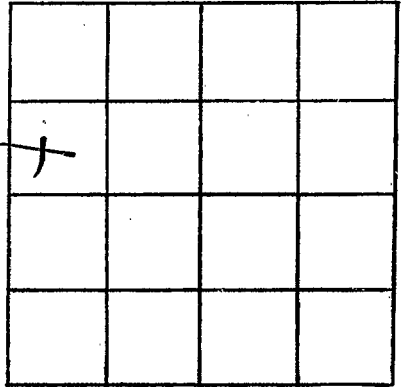

SECTION \_\_\_\_\_

Please indicate well location X.

ADDITIONAL INFORMATION

If more than one screen,  
show locations of each on sketch.