

Paul River
F 2026

MISSISSIPPI DEPARTMENT OF NATURAL RESOURCES
 Bureau of Land and Water Resources
 Southport Mall
 P.O. Box 10631
 Jackson, Mississippi 39209
WATER WELL DRILLERS LOG

July 14 1984 Clear Water Drilling Co Pearl River
 date well completed firm name county well located

LANDOWNER: Dr. Gerald B. Roberts
 (mailing address)
 WELL LOCATION:
 sec. 4 T. 2 N. R. 16 E.
S miles W of Passapatanz
 (distance) (direction) (nearest town)

WELL PURPOSE: Home
 (home, irrigation, municipal, industrial)

WELL COMPLETION DATA:
 (1) diameter (inches) 2
 (2) total depth (feet) 440
 (3) static water level (feet) 96 ^{below}/_{above} top of ground.
 (4) casing PVC 430'
 (material) (depth)
 (size) if telescope see back.
 (5) screen 10' 430'
 (length) (depth to top)
008 PVC 2"
 (size) (material)
 (6) pump 1 5
 (HP) (yield gpm)
220V
 (type power)
 (7) electric log _____
 (yes or no)
 (organization running log)
 (8) how well bottom plugged BW 100%

description of formations encountered	from	to
Top Soil	0	4
Red Clay	4	10
" " Yellow Red Sand	11	12
White Sand	12	30
tan clay	30	45
Blue Clay	45	90
Fine SP. SAND	90	115
" Tan Sand	115	125
	125	150
Red Blue Clay	115	130
Fine tan Sand	130	150
" Med Tan Sand	150	170
Blue Clay	170	210
Fine SP. Sand	210	240
Blue Clay	240	270
Fine Blue Sand	270	290
Gravel Blue Clay	290	310
Blue Clay Fine Sand	310	340
Fine S-P. SAND	340	410
MED. COARSE SP	410	440

DEPT. OF NATURAL RESOURCES
 BUREAU OF LAND & WATER RESOURCES


AUG 16 1984

RECEIVED

DRILLERS REMARKS:

If well telescopes please sketch and show depths.

GROUND LEVEL

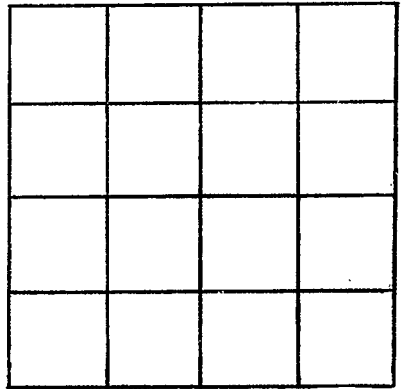

SECTION _____

Please indicate well location X.

ADDITIONAL INFORMATION

If more than one screen, show locations of each on sketch.