

MISSISSIPPI DEPARTMENT OF NATURAL RESOURCES

Bureau of Land and Water Resources

Southport Mall

P.O. Box 10631

Jackson, Mississippi 39209

WATER WELL DRILLERS LOG

Pear River
F 2028

8
 date well completed

19 86 Bur Pearson
 firm name

Pear River
 county well located

LANDOWNER: Jack Regan

R.T. 5 Box 612

Poplarwill miss 39470
 (mailing address)

description of formations encountered

from

to

white clay 0 70
white sand 70 120

WELL LOCATION:

sec. 9 T N R 16 W
8 miles north of Poplarwill
 (distance) (direction) (nearest town)

WELL PURPOSE: home
 (home, irrigation, municipal, industrial)

WELL COMPLETION DATA:

- (1) diameter (inches) 4"
- (2) total depth (feet) 120
- (3) static water level (feet) 70 below above top of ground.
- (4) casing PVC, 110,
 (material) (depth)
 (size) if telescope see back.
- (5) screen 10, 110
 (length) (depth to top)
12, PVC
 (size) (material)
- (6) pump 1/2, 600
 (HP) (yield gpm)
Elect
 (type power)
- (7) electric log no
 (yes or no)

(organization running log)

(8) how well bottom plugged hard
sharp

DRILLERS REMARKS:


RECEIVED

JUN 12 1987

Department of Natural Resources
 Bureau of Land & Water Resources

If well telescopes please sketch and show depths.

GROUND LEVEL

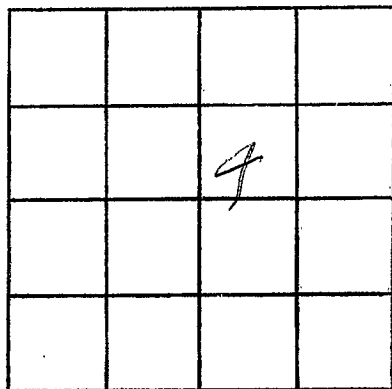

SECTION _____

Please indicate well location X.

ADDITIONAL INFORMATION

If more than one screen,
show locations of each on sketch.