

MISSISSIPPI DEPARTMENT OF NATURAL RESOURCES

Bureau of Land and Water Resources

Southport Mall

P.O. Box 10631

Jackson, Mississippi 39209

WATER WELL DRILLERS LOG

*002 All
POM*

PEARL RIVER
F 2029

Sept. 13 1986 St. Clair Water Drilling PEARL RIVER
date well completed firm name county well located

LANDOWNER: O. Dunn
Poplarville Miss
39470
(mailing address)

WELL LOCATION:
sec. 14 T. 2 N. R. 16 E.
3 miles NW of Poplarville
(distance) (direction) (nearest town)

WELL PURPOSE:
(home, irrigation, municipal, industrial)

WELL COMPLETION DATA:
(1) diameter (inches) 4"
(2) total depth (feet) 230
(3) static water level (feet) 110 below above top of ground.
(4) casing PVC 240
(material) (depth)
(size) If telescope see back.
(5) screen 10 240
(length) (depth to top)
010 PVC Slot
(size) (material)
(6) pump 1 18
(HP) (yield gpm)
220
(type power)
(7) electric log (yes or no) (no)
(organization running log)
(8) how well bottom plugged SS

description of formations encountered	from	to
<u>top</u>		<u>2"</u>
<u>Red Clay</u>	<u>20</u>	<u>40</u>
<u>Tan Sand</u>	<u>40</u>	<u>70</u>
<u>Tan Clay Red Clay mix</u>	<u>70</u>	<u>150</u>
<u>Blue Clay</u>	<u>150</u>	<u>210</u>
<u>Tan Sand red.</u>	<u>210</u>	<u>230</u>

RECEIVED


NOV 21 1986

Department of Natural Resources
Bureau of Land & Water Resources

DRILLERS REMARKS:

If well telescopes please
sketch and show depths.

GROUND LEVEL

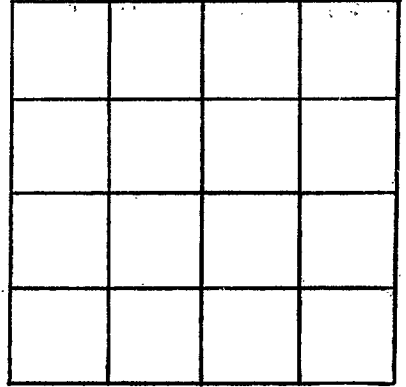

SECTION _____

Please indicate well location X.

ADDITIONAL INFORMATION

If more than one screen,
show locations of each on sketch.