

MISSISSIPPI DEPARTMENT OF NATURAL RESOURCES

Bureau of Land and Water Resources

Southport Mall

P.O. Box 10631

Jackson, Mississippi 39209

WATER WELL DRILLERS LOG

Pearl River  
F 2030

3-20-87 date well completed Jerry S. Smith firm name PEARL R. county well located

LANDOWNER: Howl amodley  
Pop Larnell miss  
Route 1  
(mailing address)

description of formations encountered	from to	
SANDY SOIL	0	3
RED CLAY	3	20
WHITE SAND	20	27
RED SAND CLAY	27	40
SAND	40	53

WELL LOCATION:  
sec. 40 T. 2 N. R. 16 E.  
5 miles N of CROSS R  
(distance) (direction) (nearest town)

WELL PURPOSE:  
(home) irrigation, municipal, industrial

WELL COMPLETION DATA:

(1) diameter (inches) 4

(2) total depth (feet) 50

(3) static water level (feet) 17 below top of ground.

(4) casing PVC (material), 50 (depth)

4 (size) If telescope see back.

(5) screen 10 (length), (depth to top) 4 (size), PVC (material)

(6) pump 1/2 (HP), 17 (yield gpm)  
Elec. (type power)

(7) electric log (yes-or no)

(organization running log)

(8) how well bottom plugged PVC  
Wahl

RECEIVED


JUN 16 1987

Department of Natural Resources  
Bureau of Land & Water Resources

DRILLERS REMARKS:

If well telescopes please sketch and show depths.

GROUND LEVEL

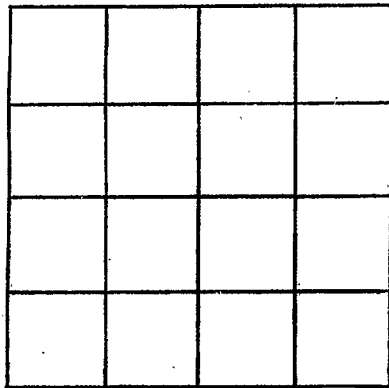

SECTION \_\_\_\_\_

Please indicate well location X.

ADDITIONAL INFORMATION

If more than one screen,  
show locations of each on sketch.