

MISSISSIPPI DEPARTMENT OF NATURAL RESOURCES

Bureau of Land and Water Resources

Southport Mall

P.O. Box 10631

Jackson, Mississippi 39209

WATER WELL DRILLERS LOG

Pearl River
F
2031

4-17-88 Griner Drilling Service, Inc. Pearl River
 date well completed Service, Inc. county well located

LANDOWNER:	description of formations encountered	from	to
<u>Exxon Company USA</u> <u>P.O. Box 4301</u> <u>Houston, TX. 77210</u> (mailing address)	<u>clay</u>	<u>0</u>	<u>100</u>
	<u>sand</u>	<u>100</u>	<u>139</u>
WELL LOCATION: <u>2949'N & 2093'W</u> <u>No. 14</u> <u>20</u> T <u>2</u> N R <u>16</u> E of <u>SE/CO</u> <u>Southern Minerals Corp.</u> <u>Poplarville Field</u> (distance) (direction) (nearest town)	<u>clay</u>	<u>139</u>	<u>315</u>
	<u>sand</u>	<u>315</u>	<u>412</u>
WELL PURPOSE: <u>oilfield / rig</u> (home, irrigation, municipal, industry)	<u>clay</u>	<u>412</u>	<u>496</u>
WELL COMPLETION DATA:	<u>sand</u>	<u>496</u>	<u>588</u>
(1) diameter (inches) <u>4"</u>	<u>No. 1 Water Well</u>		
(2) total depth (feet) <u>588'</u>			
(3) static water level (feet) <u>100'</u> <u>below</u> top of ground.			
(4) casing <u>steel, 543'</u> (material) (depth) <u>4"</u> (size) If telescope see back.			
(5) screen <u>42', 501'</u> (length) (depth to top) <u>4" perforated</u> (size) (material)			
(6) pump <u>80</u> (HP) (yield gpm) <u>AC</u> (type power)			
(7) electric log <u>no</u> (yes or no)			
(organization running log)			
(8) how well bottom plugged <u>orange peel</u>			
DRILLERS REMARKS:			


RECEIVED

MAY 27 1988

Department of Natural Resources
 Bureau of Land & Water Resources

If well telescopes please sketch and show depths.

GROUND LEVEL

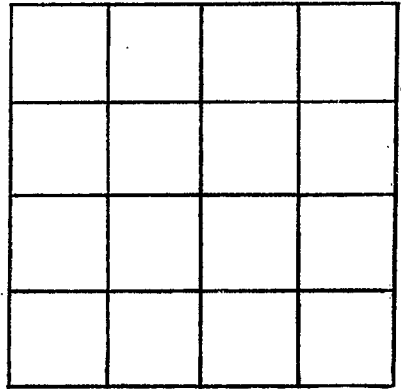

SECTION _____

Please indicate well location X.

ADDITIONAL INFORMATION

If more than one screen, show locations of each on sketch.