

MISSISSIPPI DEPARTMENT OF NATURAL RESOURCES
 Bureau of Land and Water Resources
 Southport Mall
 P.O. Box 10631
 Jackson, Mississippi 39209
WATER WELL DRILLERS LOG

P. River
F 2035

1-31-89 19 Beard & Benton Beard Aides
 date well completed firm name county well located

LANDOWNER: Wayne Alexander
R.T. 3 Box 288
Poplarville Miss 39470
 (mailing address)

description of formations encountered	from	to
	<u>red sand</u>	<u>0</u>
<u>blue shale</u>	<u>20</u>	<u>418</u>
<u>gray sand</u>	<u>140</u>	<u>242</u>

WELL LOCATION:
 sec. 23 T. 2 N. R. 16 E.
 S. W. W.
1 miles NW of Poplarville
 (distance) (direction) (nearest town)

WELL PURPOSE: home
 (home, irrigation, municipal, industrial)

WELL COMPLETION DATA:

- (1) diameter (inches) 4"
- (2) total depth (feet) 442
- (3) static water level (feet) 160 below above top of ground.
- (4) casing DVC 4 1/2"
 (material) (depth)
4 1/2" if telescope see back.
 (size)
- (5) screen 10 432
 (length) (depth to top)
1/4" pvc
 (size) (material)
- (6) pump 1/2 10
 (HP) (yield gpm)
Elect.
 (type power)
- (7) electric log no
 (yes or no)
 (organization running log)
- (8) how well bottom plugged sub sand
shark

DRILLERS REMARKS:


RECEIVED

MAR 27 1989

Department of Natural Resources
 Bureau of Land & Water Resources

If well telescopes please sketch and show depths.

GROUND LEVEL

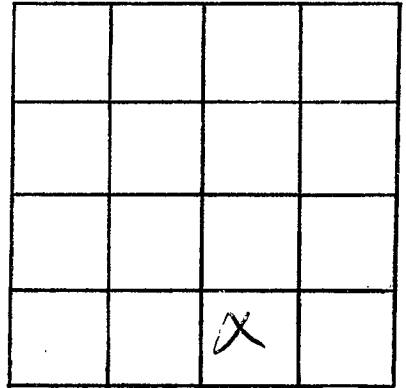

SECTION _____

Please indicate well location X.

ADDITIONAL INFORMATION

If more than one screen,
show locations of each on sketch.