

MISSISSIPPI DEPARTMENT OF NATURAL RESOURCES
Bureau of Land and Water Resources
 Southport Mall
 P.O. Box 10631
 Jackson, Mississippi 39209
WATER WELL DRILLERS LOG

P. RIVER
F 2036

2/1 date well completed 1989 Bud Penton firm name Pearl River county well located
Waters Well


LANDOWNER: Wagne Alexander
R T-3 Box 288
Poplarville miss 39470
 (mailing address)

description of formations encountered	from	to
<u>Red shale</u>	<u>0</u>	<u>20</u>
<u>Blue shale</u>	<u>20</u>	<u>41.6</u>
<u>gray sand</u>	<u>41.6</u>	<u>44.2</u>

WELL LOCATION:
 sec. 23 T 2 N S R 16 E W
1 1/2 miles West of Poplarville
 (distance) (direction) (nearest town)

WELL PURPOSE: Home
 (home, irrigation, municipal, industrial)

- WELL COMPLETION DATA:
- (1) diameter (inches) 4
 - (2) total depth (feet) 44.2
 - (3) static water level (feet) 150 below above top of ground.
 - (4) casing PVC, 44.2,
 (material) (depth)
4x2 if telescope see back.
 (size)
 - (5) screen 10, 4.32
 (length) (depth to top)
12, PVC
 (size) (material)
 - (6) pump 1 1/2, 18
 (HP) (yield gpm)
Elect
 (type power)
 - (7) electric log no
 (yes or no)
- (organization running log)
- (8) how well bottom plugged good
shark

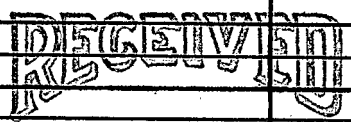

MAY 24 1989

Department of Natural Resources
 Bureau of Land & Water Resources

DRILLERS REMARKS:

